




DELAVAN, WIS. 53115

PLAT OF SURVEY

DESCRIPTION: All of Out Lot 90 of the Assessor's Plat of Walworth, located in the NW.1/4 of Section 22, T.1 N., R.16 E., Village of Walworth, Walworth Co., Wisconsin.

C/L FRANKLIN ST. (40'R/W)

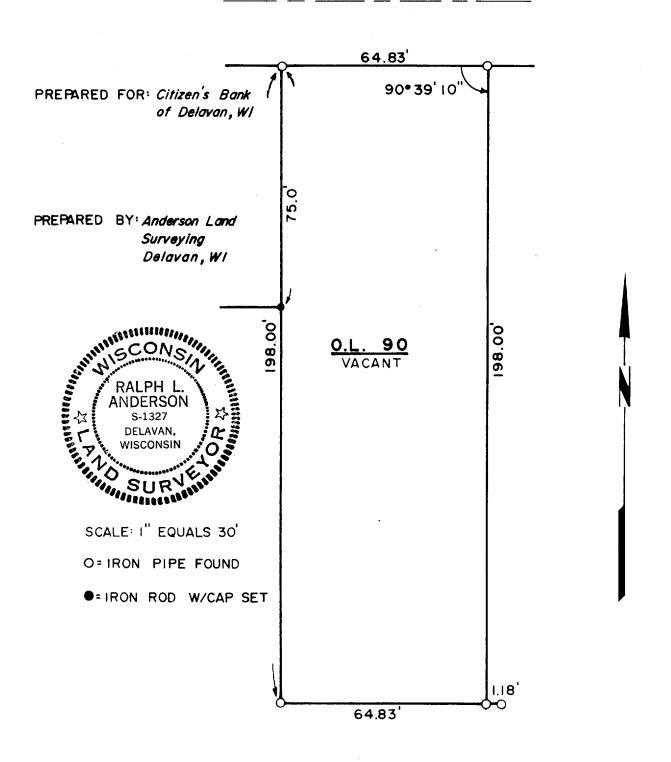

SURVEYOR'S CERTIFICATE

I HEREBY CERTIFY THAT! HAVE SURVEYED THE ABOVE DESCRIBED PROPERTY AND THE ABOVE MAP IS A TRUE REPRESENTATION THEREOF AND SHOWS THE SIZE AND LOCATION OF THE PROPERTY, ITS EXTERIOR BOUNDARIES, THE LOCATION AND DIMENSIONS OF ALL VISIBLE STRUCTURES THEREON. THIS SURVEY IS MADE FOR THE EXCLUSIVE USE OF THE PRESENT OWNERS OF THE PROPERTY, AND ALSO THOSE WHO PURCHASE, MORTGAGE, OR GUARANTEE THE TITLE THERETO WITHIN ONE (I) YEAR FROM DATE HEREOF.

DATE 27 AUG. 1984

SURVEYOR Salph L. Underson

JOB NO. 23384

9-234