

DUNHAM SURVEYING, S.C. SURVEYING & SUBDIVIDING DELAVAN, WISCONSIN 53115

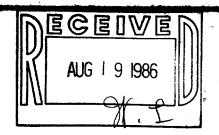

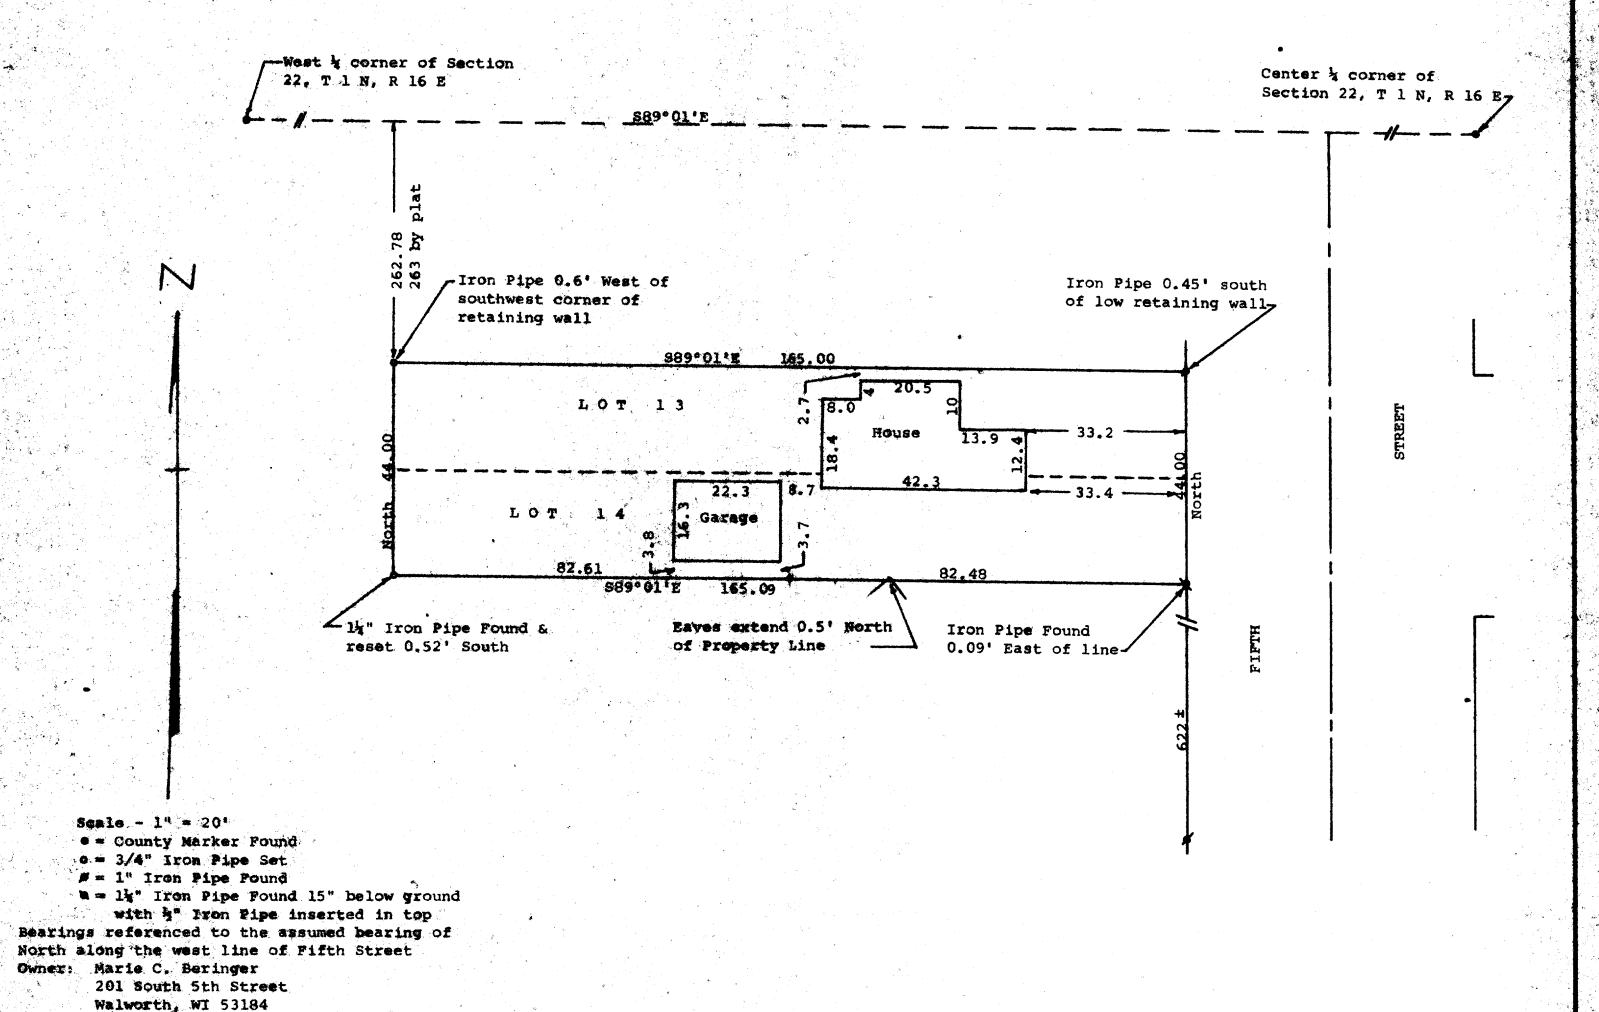

STATE OF WISCONSIN) SS COUNTY OF WALMORTH)

I, George T. Dunham, Surveyor, certify that I have surveyed the property described as follows:

Lots 13 and 14, Block 1, East Side Addition, located in the Village of Walworth, Walworth County, Wisconsin, and that the map shown above is a true representation thereof and shows the size and location of the property, its exterior boundaries, the location of all visible structures and dimensions of all principal buildings thereon, boundary fences, apparent easements, roadways and visible encroachments, if any, and that I have surveyed the property hereon described according

to the official records, to the best of my knowledge and belief. October 5, 1984

George T. Dunham, Surveyor

