

WALWORTH COUNTY SURVEYING & MAPPING LAKE GENEVA, WISCONSIN

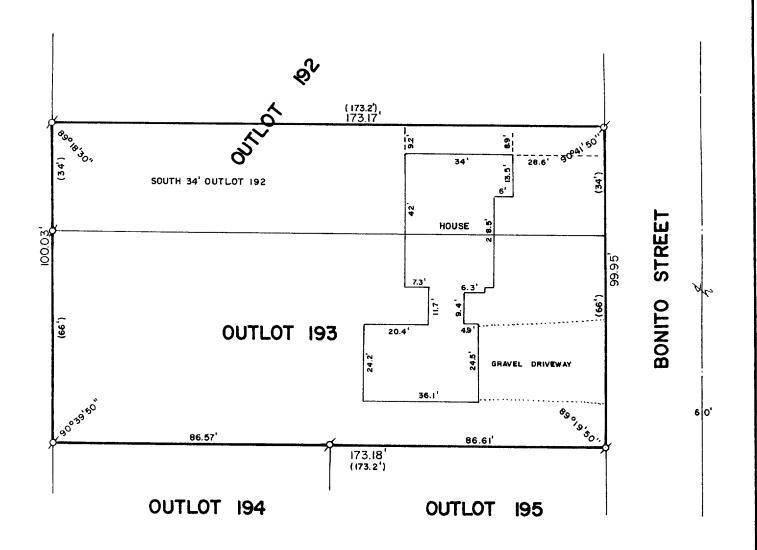

PLAT OF SURVEY OF

OUTLOT 193 AND THE SOUTH 193 FEET OF OUTLOT 192 OF THE ASSESSOR'S PLAT OF THE VILLAGE OF WALWORTH, WALWORTH COUNTY, WISCONSIN.

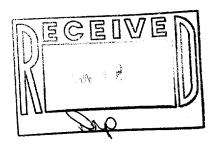

ORDERED BY: REDELL REALTY

506 MADISON STREET LAKE GENEVA, WISCONSIN 53147



SCALE: 1"=30"

ø -IRON PIPE FOUND ()-PECORDED AS I, ROBERT M. BAERENWALD, DO HEREBY CERTIFY THAT I HAVE SURVEYED THE PROPERTY HEREON DESCRIBED ACCORDING TO THE OFFICIAL RECORDS AND THAT THE PLAT HEREON IS A CORRECT REPRESENTATION OF THE PROPERTY LINES TO THE BEST OF MY KNOWLEDGE AND BELIEF.

ROBERT M. BAERENWALD

WISCONSIN REGISTERED LAND SURVEYOR, S-1508

DATE JOB NO. 1348

NOTE: THIS IS NOT A CERTIFIED COPY UNLESS SEALED.