
ABELL

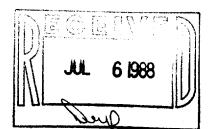

SURVEYING & MAPPING DELAVAN, WISCONSIN 53115 414-728-6737


65.91 (66')

90° 43.4

PLAT OF SURVEY OF

LOT 8 OF CLARKES SECOND ADDITION TO THE VILLAGE OF WALWORTH AND THE SOUTH 50 FEET OF LOT 28 OF CLARKES ADDITION TO THE VILLAGE OF WALWORTH, WALWORTH COUNTY, WISCONSIN.

ORDERED BY:

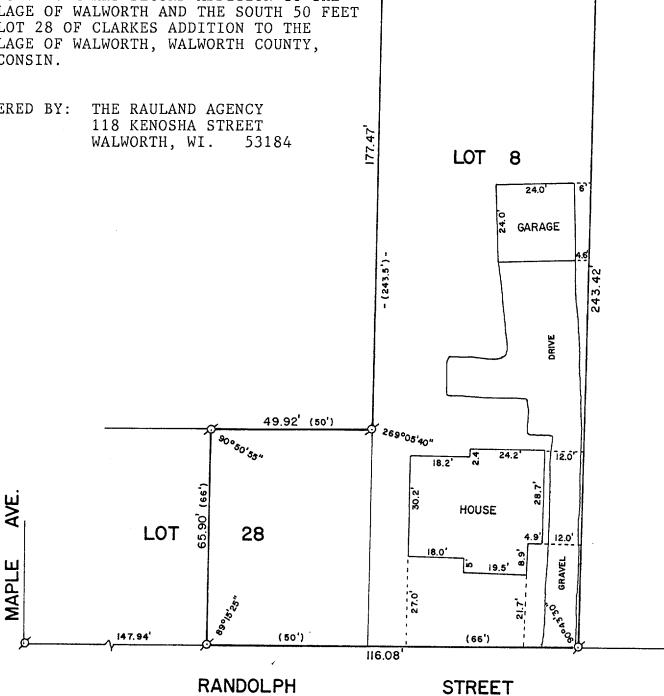



1"=30' SCALE $\varphi - IRON \frac{LEGEND}{PIPE} FOUND$ ()- RECORDED AS

I, DAVID F. ABELL, DO HEREBY CERTIFY THAT I HAVE SURVEYED THE PROPERTY HEREON DESCRIBED ACCORDING TO THE OFFICIAL RECORDS AND THAT THE PLAT HEREON IS A CORRECT REPRESENTATION OF THE PROPERTY LINES TO THE BEST OF MY KNOWLEDGE AND BELIEF.

DAVID F. ABELL WISCONSIN REGISTERED LAND SURVEYOR, S-1596

1988

JOB NUMBER - 88127 THIS IS NOT A CERTIFIED COPY UNLESS SEALED.

UCA 3-10 + UCA-37