
ABELL SURVEYING & MAPPING DELAVAN, WISCONSIN 53115



HOWARD

STREET

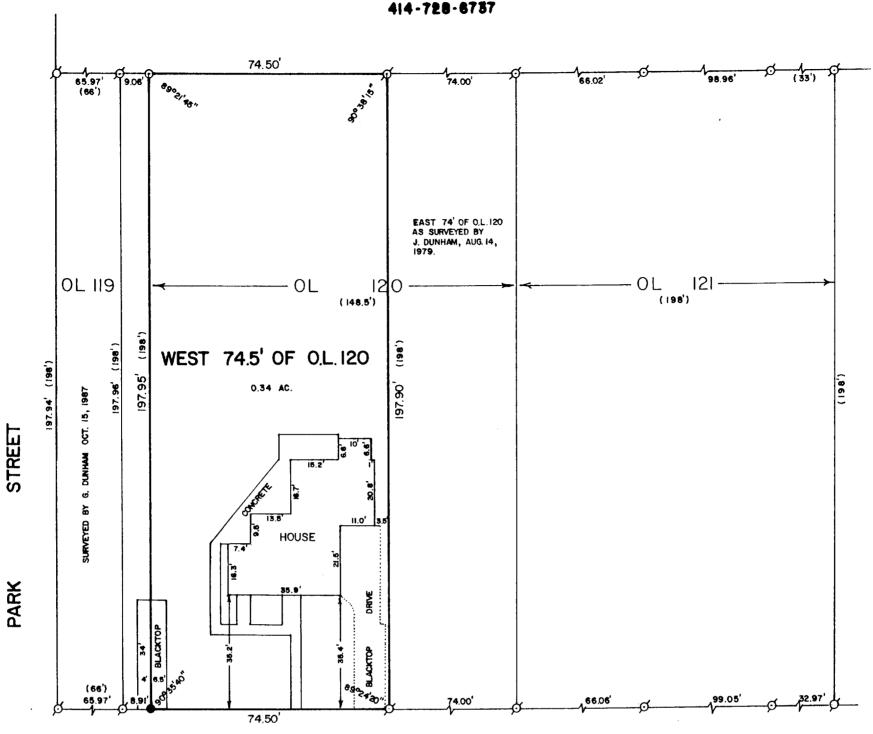

SCALE

1"=30'

+ - CUT CROSS IN CONCRETE FOUND

• - P.K. NAIL SET
()- RECORDED AS

PLAT OF SURVEY OF

(420.75')

THE WEST 74.5 FEET OF OUTLOT 120 OF THE ASSESSOR'S PLAT OF THE VILLAGE OF WALWORTH, WALWORTH COUNTY, WISCONSIN.

ORDERED BY: VACATION PROPERTIES NETWORK

101 BROAD STREET

LAKE GENEVA, WI. 53147


NOTE: THIS SURVEY IS BASED ON A SURVEY BY LLOYD L. JENSEN

DATED 1952. SAID SURVEY IS ON RECORD IN THE WALWORTH

COUNTY SURVEYORS OFFICE.

I HEREBY CERTIFY THAT I HAVE SURVEYED THE ABOVE DESCRIBED PROPERTY AND THAT THE ABOVE HAP IS A TRUE REPRESENTATION THEREOF AND SHOWS THE SIZE AND LOCATION OF THE PROPERTY, ITS EXTERIOR BOUNDARIES, THE LOCATION OF ALL VISIBLE STRUCTURES AND DIHENSIONS OF ALL PRINCIPAL BUILDINGS THEREON, BOUNDARY FENCES, APPARENT EASEMENTS, ROADWAYS AND VISIBLE ENCROACHMENTS, IF ANY, TO THE BEST OF MY KNOWLEDGE AND BELIEF.

THIS SURVEY IS HADE FOR THE USE OF THE PRESENT OWNERS OF THE PROPERTY, AND ALSO THOSE WHO PURCHASE, MORTGAGE, OR GUARANTEE THE TITLE THERETO WITHIN ONE (1) YEAR FROM DATE HEREOF.

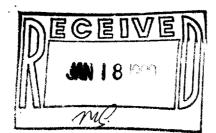

Savid 7. abell

DAVID F. ABELL WISCONSIN REGISTERED LAND SURVEYOR, S-1596

September 25, 1989 DATE JOB NUMBER - 89198

DATE JOB NUMBER - 89198
NOTE: THIS IS NOT A CERTIFIED COPY UNLESS SEALED.