
## ABELL SURVEYING & MAPPING DELAYAN, WISCONSIN 53115 414-728-6787

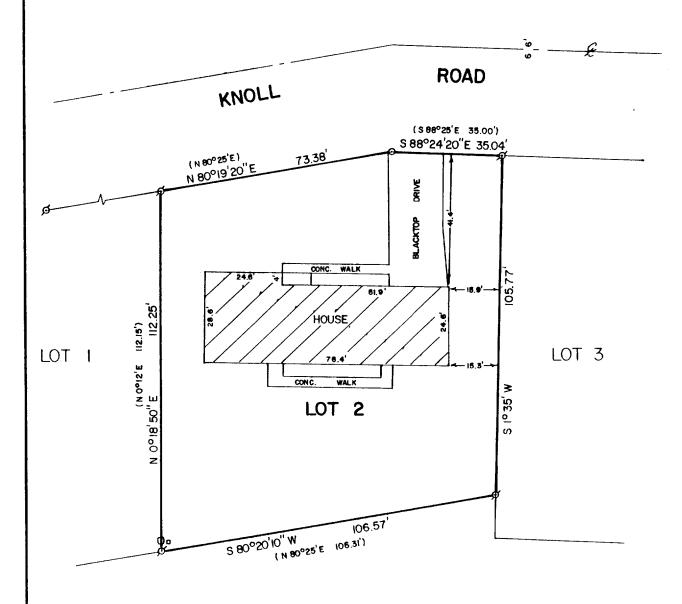

## PLAT OF SURVEY OF


LOT 2 OF THE MEADOWS OF WALWORTH, A SUBDIVISION LOCATED IN THE NORTHWEST 1/4 OF SECTION 27, T1N,R16E, VILLAGE OF WALWORTH, WALWORTH COUNTY, WISCONSIN.

ORDERED BY: THE RAULAND AGENCY

118 KENOSHA STREET WALWORTH, WI. 53184

NOTE: THE BEARING ON THE EAST LINE OF LOT 2 IS ASSUMED AS

SHOWN ON THE SUBDIVISION PLAT.

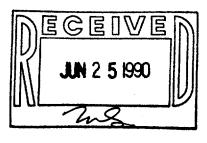

90087



SCALE - 1"=30'

 $\begin{array}{c} \textbf{LEGEND} \\ \textbf{p} - \textbf{IRON} \ \textbf{PIPE} \ \textbf{FOUND} \end{array}$ 

• - IRON ROD SET ( )- RECORDED AS

O. - UTILITY PED.

I HEREBY CERTIFY THAT I HAVE SURVEYED THE ABOVE DESCRIBED PROPERTY AND THAT THE ABOVE HAP IS A TRUE REPRESENTATION THEREOF AND SHOWS THE SIZE AND LOCATION OF THE PROPERTY, ITS EXTERIOR BOUNDARIES, THE LOCATION OF ALL VISIBLE STRUCTURES AND DIMENSIONS OF ALL PRINCIPAL BUILDINGS THEREON, BOUNDARY FENCES, APPARENT EASEHENTS, ROADWAYS AND VISIBLE ENCROACHMENTS, IF ANY, TO THE BEST OF MY KNOWLEDGE AND BELIEF.

THIS SURVEY IS MADE FOR THE USE OF THE PRESENT OWNERS OF THE PROPERTY, AND ALSO THOSE WHO PURCHASE, HORTGAGE, OR GUARANTEE THE TITLE THERETO WITHIN ONE (1) YEAR FROM DATE HEREOF.

Sand 7. Abell

WISCONSIN REGISTERED LAND SURVEYOR, 5-1596

May 16, 1990

BAIR
NOTE: THIS IS NOT A CERTIFIED COPY UNLESS SEALED.

TAX # VMW-Z

9-376