


ABELL SURVEYING & MAPPING

DELAVAN, WISCONSIN 53115

414-728-6737

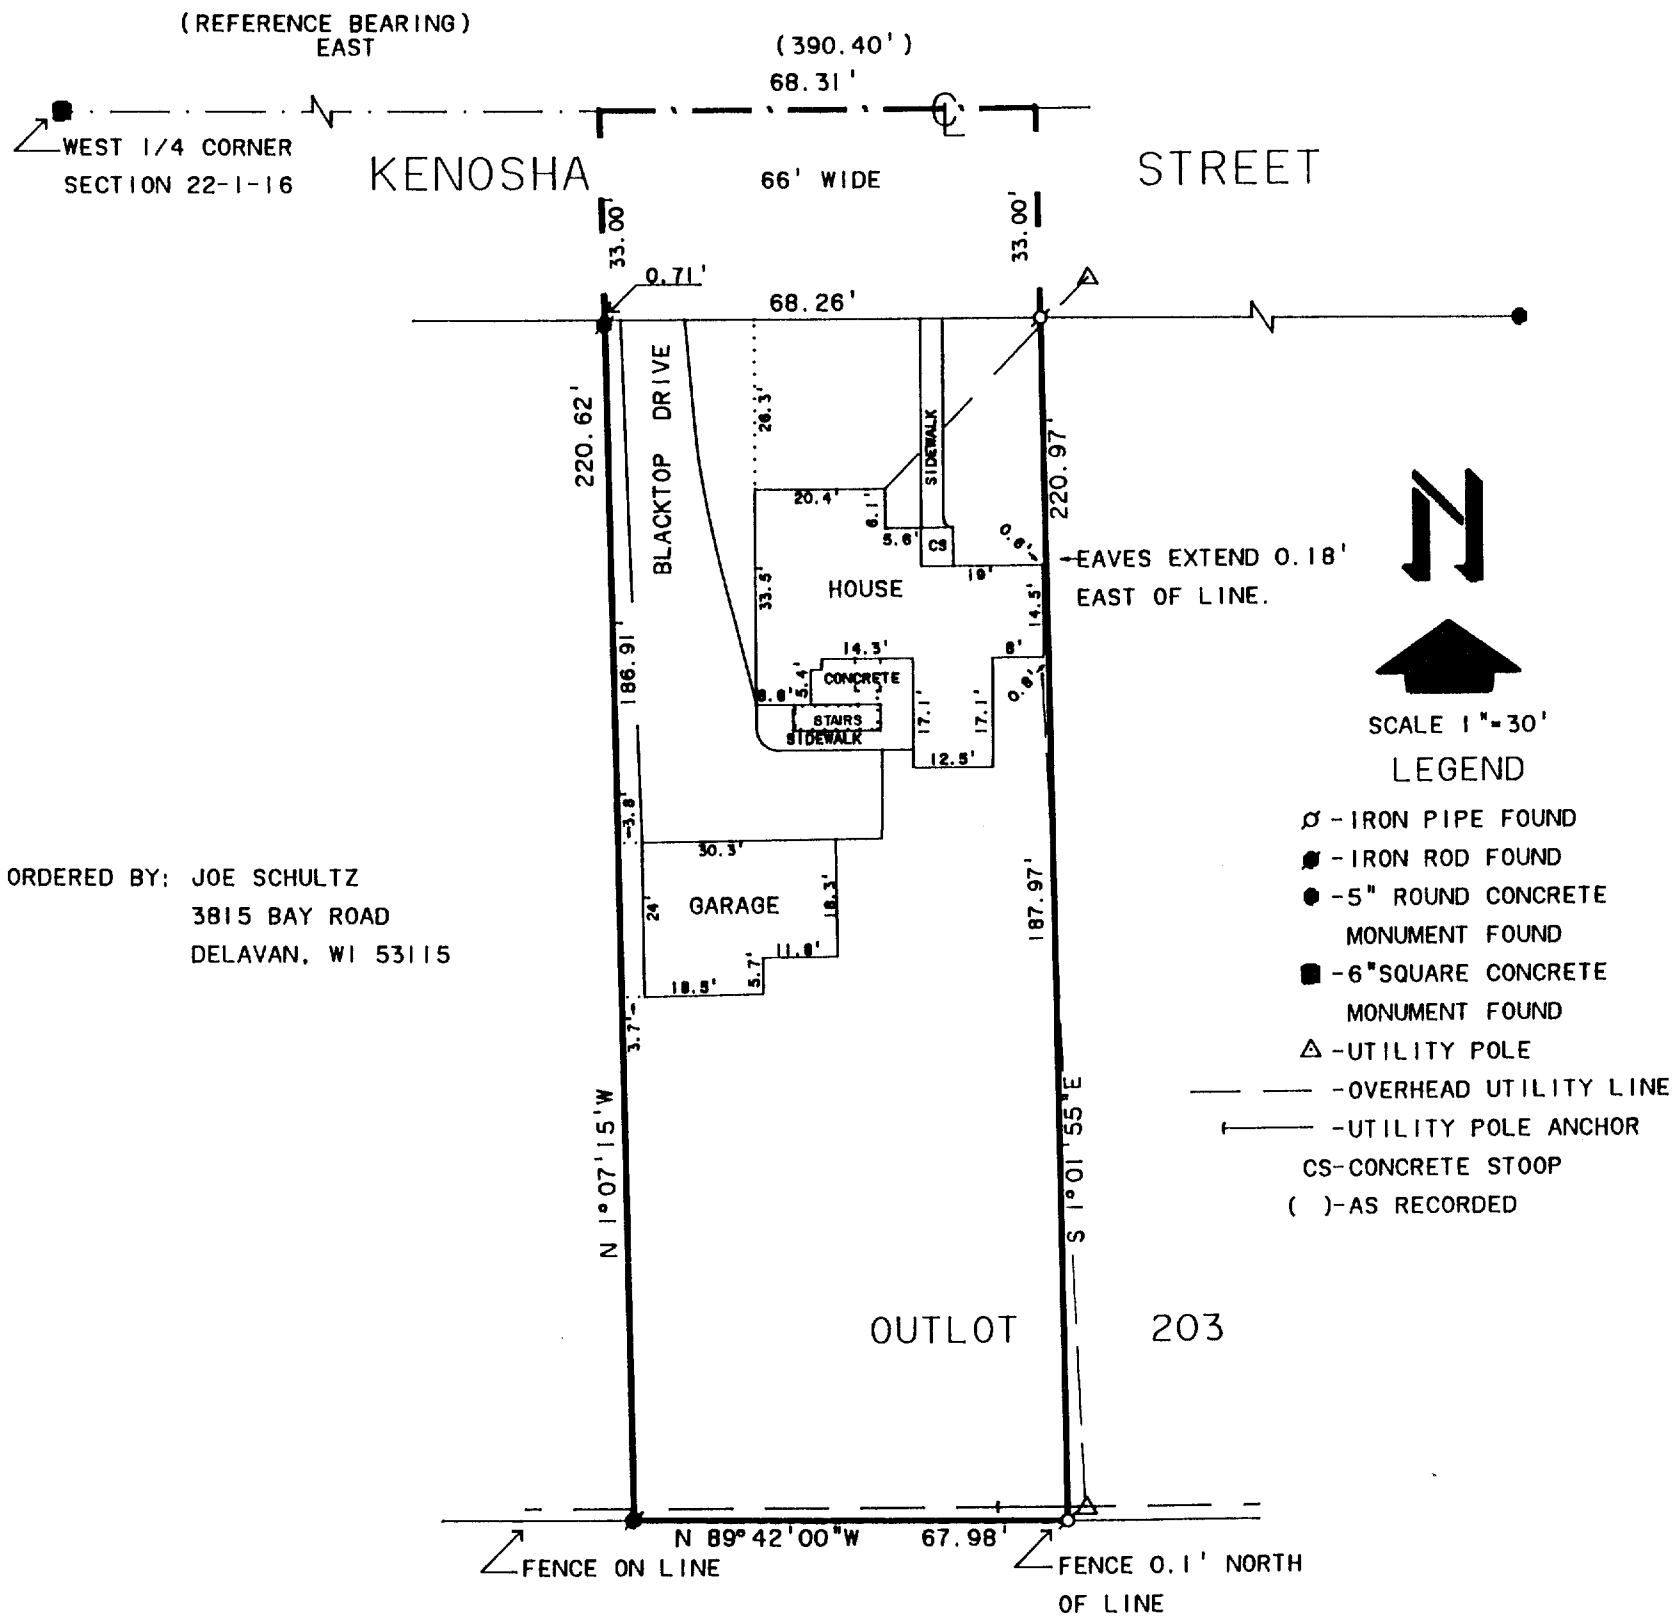


ORDERED BY: JOE SCHULTZ
3815 BAY ROAD
DELAVAN, WI 53115

PLAT OF SURVEY OF

OUTLOT 203 OF THE ASSESSOR'S PLAT OF THE VILLAGE OF
WALWORTH, WALWORTH COUNTY, WISCONSIN EXCEPTING THE
EAST 65.00 FEET OF SAID OUTLOT.

I HEREBY CERTIFY THAT I HAVE SURVEYED THE ABOVE DESCRIBED PROPERTY AND THAT THE ABOVE MAP IS A TRUE REPRESENTATION THEREOF AND SHOWS THE SIZE AND LOCATION OF THE PROPERTY, ITS EXTERIOR BOUNDARIES, THE LOCATION OF ALL VISIBLE STRUCTURES AND DIMENSIONS OF ALL PRINCIPAL BUILDINGS THEREON, BOUNDARY FENCES, APPARENT EASEMENTS, ROADWAYS AND VISIBLE ENCROACHMENTS, IF ANY, TO THE BEST OF MY KNOWLEDGE AND BELIEF.

THIS SURVEY IS MADE FOR THE USE OF THE PRESENT OWNERS OF THE PROPERTY, AND ALSO THOSE WHO PURCHASE, MORTGAGE, OR GUARANTEE THE TITLE THERETO WITHIN ONE (1) YEAR FROM DATE HEREOF.

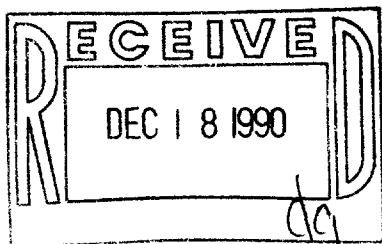

David F. Abell

DAVID F. ABELL
WISCONSIN REGISTERED LAND SURVEYOR, S-1596

October 24, 1990

DATE JOB NUMBER 90214

NOTE: THIS IS NOT A CERTIFIED COPY UNLESS SEALED.

007-400

VWP 00267