
## ABELL SURVEYING & MAPPING DELAVAN, WISCONSIN 53115 414-728-6787

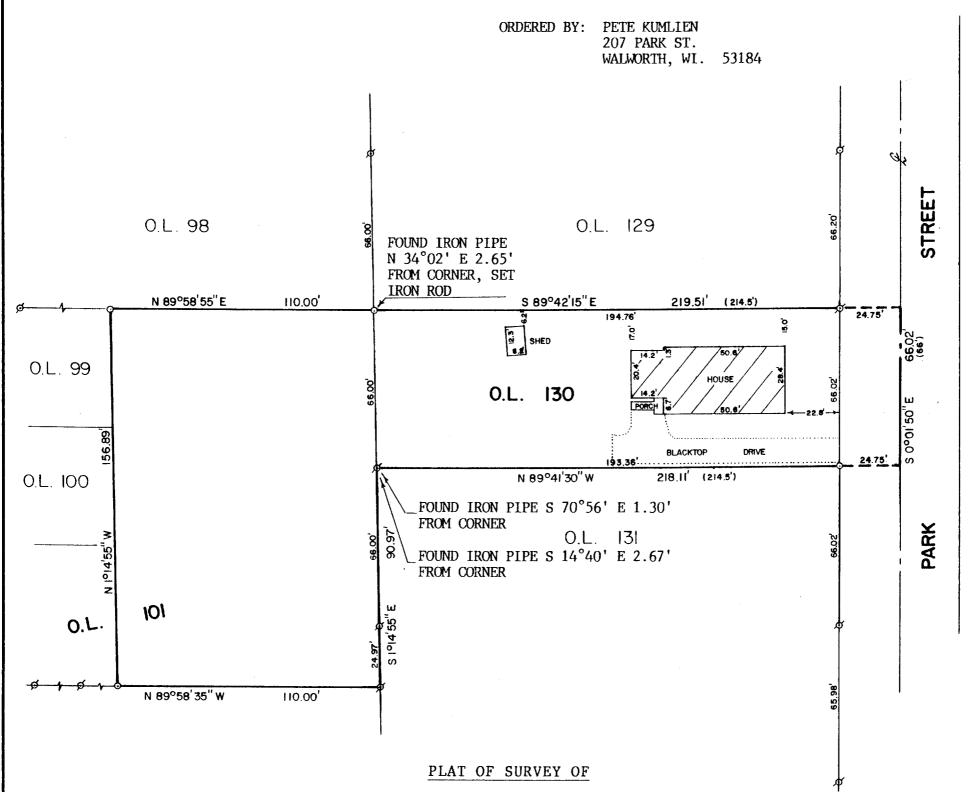

OUTLOT 130 OF THE ASSESSOR'S PLAT OF THE VILLAGE OF WALWORTH AS DESCRIBED IN VOLUME 623 OF DEEDS, PAGE 225 AND THE EAST 110 FEET OF OUTLOT 101 OF THE ASSESSOR'S PLAT OF THE VILLAGE OF WALWORTH, ALL LOCATED IN WALWORTH COUNTY, WISCONSIN.

NOTE: BEARING ARE REFERENCED TO THE WEST LINE OF PARK STREET.



DEC | 8 1990

SCALE - 1''=40'

I HEREBY CERTIFY THAT I HAVE SURVEYED THE ABOVE DESCRIBED PROPERTY AND THAT THE ABOVE MAP IS A TRUE REPRESENTATION THEREOF AND SHOWS THE SIZE AND LOCATION OF THE PROPERTY, ITS EXTERIOR BOUNDARIES, THE LOCATION OF ALL VISIBLE STRUCTURES AND DIMENSIONS OF ALL PRINCIPAL BUILDINGS THEREON, BOUNDARY FENCES, APPARENT EASEMENTS, ROADWAYS AND VISIBLE ENCROACHMENTS, IF ANY, TO THE BEST OF MY KNOWNLEDGE AND BELIEF.

THIS SURVEY IS MADE FOR THE USE OF THE PRESENT OWNERS OF THE PROPERTY, AND ALSO THOSE WHO PURCHASE, MORTGAGE, OR GUARANTEE THE TITLE THERETO WITHIN ONE (1) YEAR FROM THE DATE HEREOF.

DAVID F. ABELL

WISCONSIN REGISTERED LAND SURVEYOR, S-1596

May 15, 1990

DATE JOB NUMBER - 90069

NOTE: THIS IS NOT A CERTIFIED COPY UNLESS SEALED.

Aug Adu

\$\$9-401