



Z

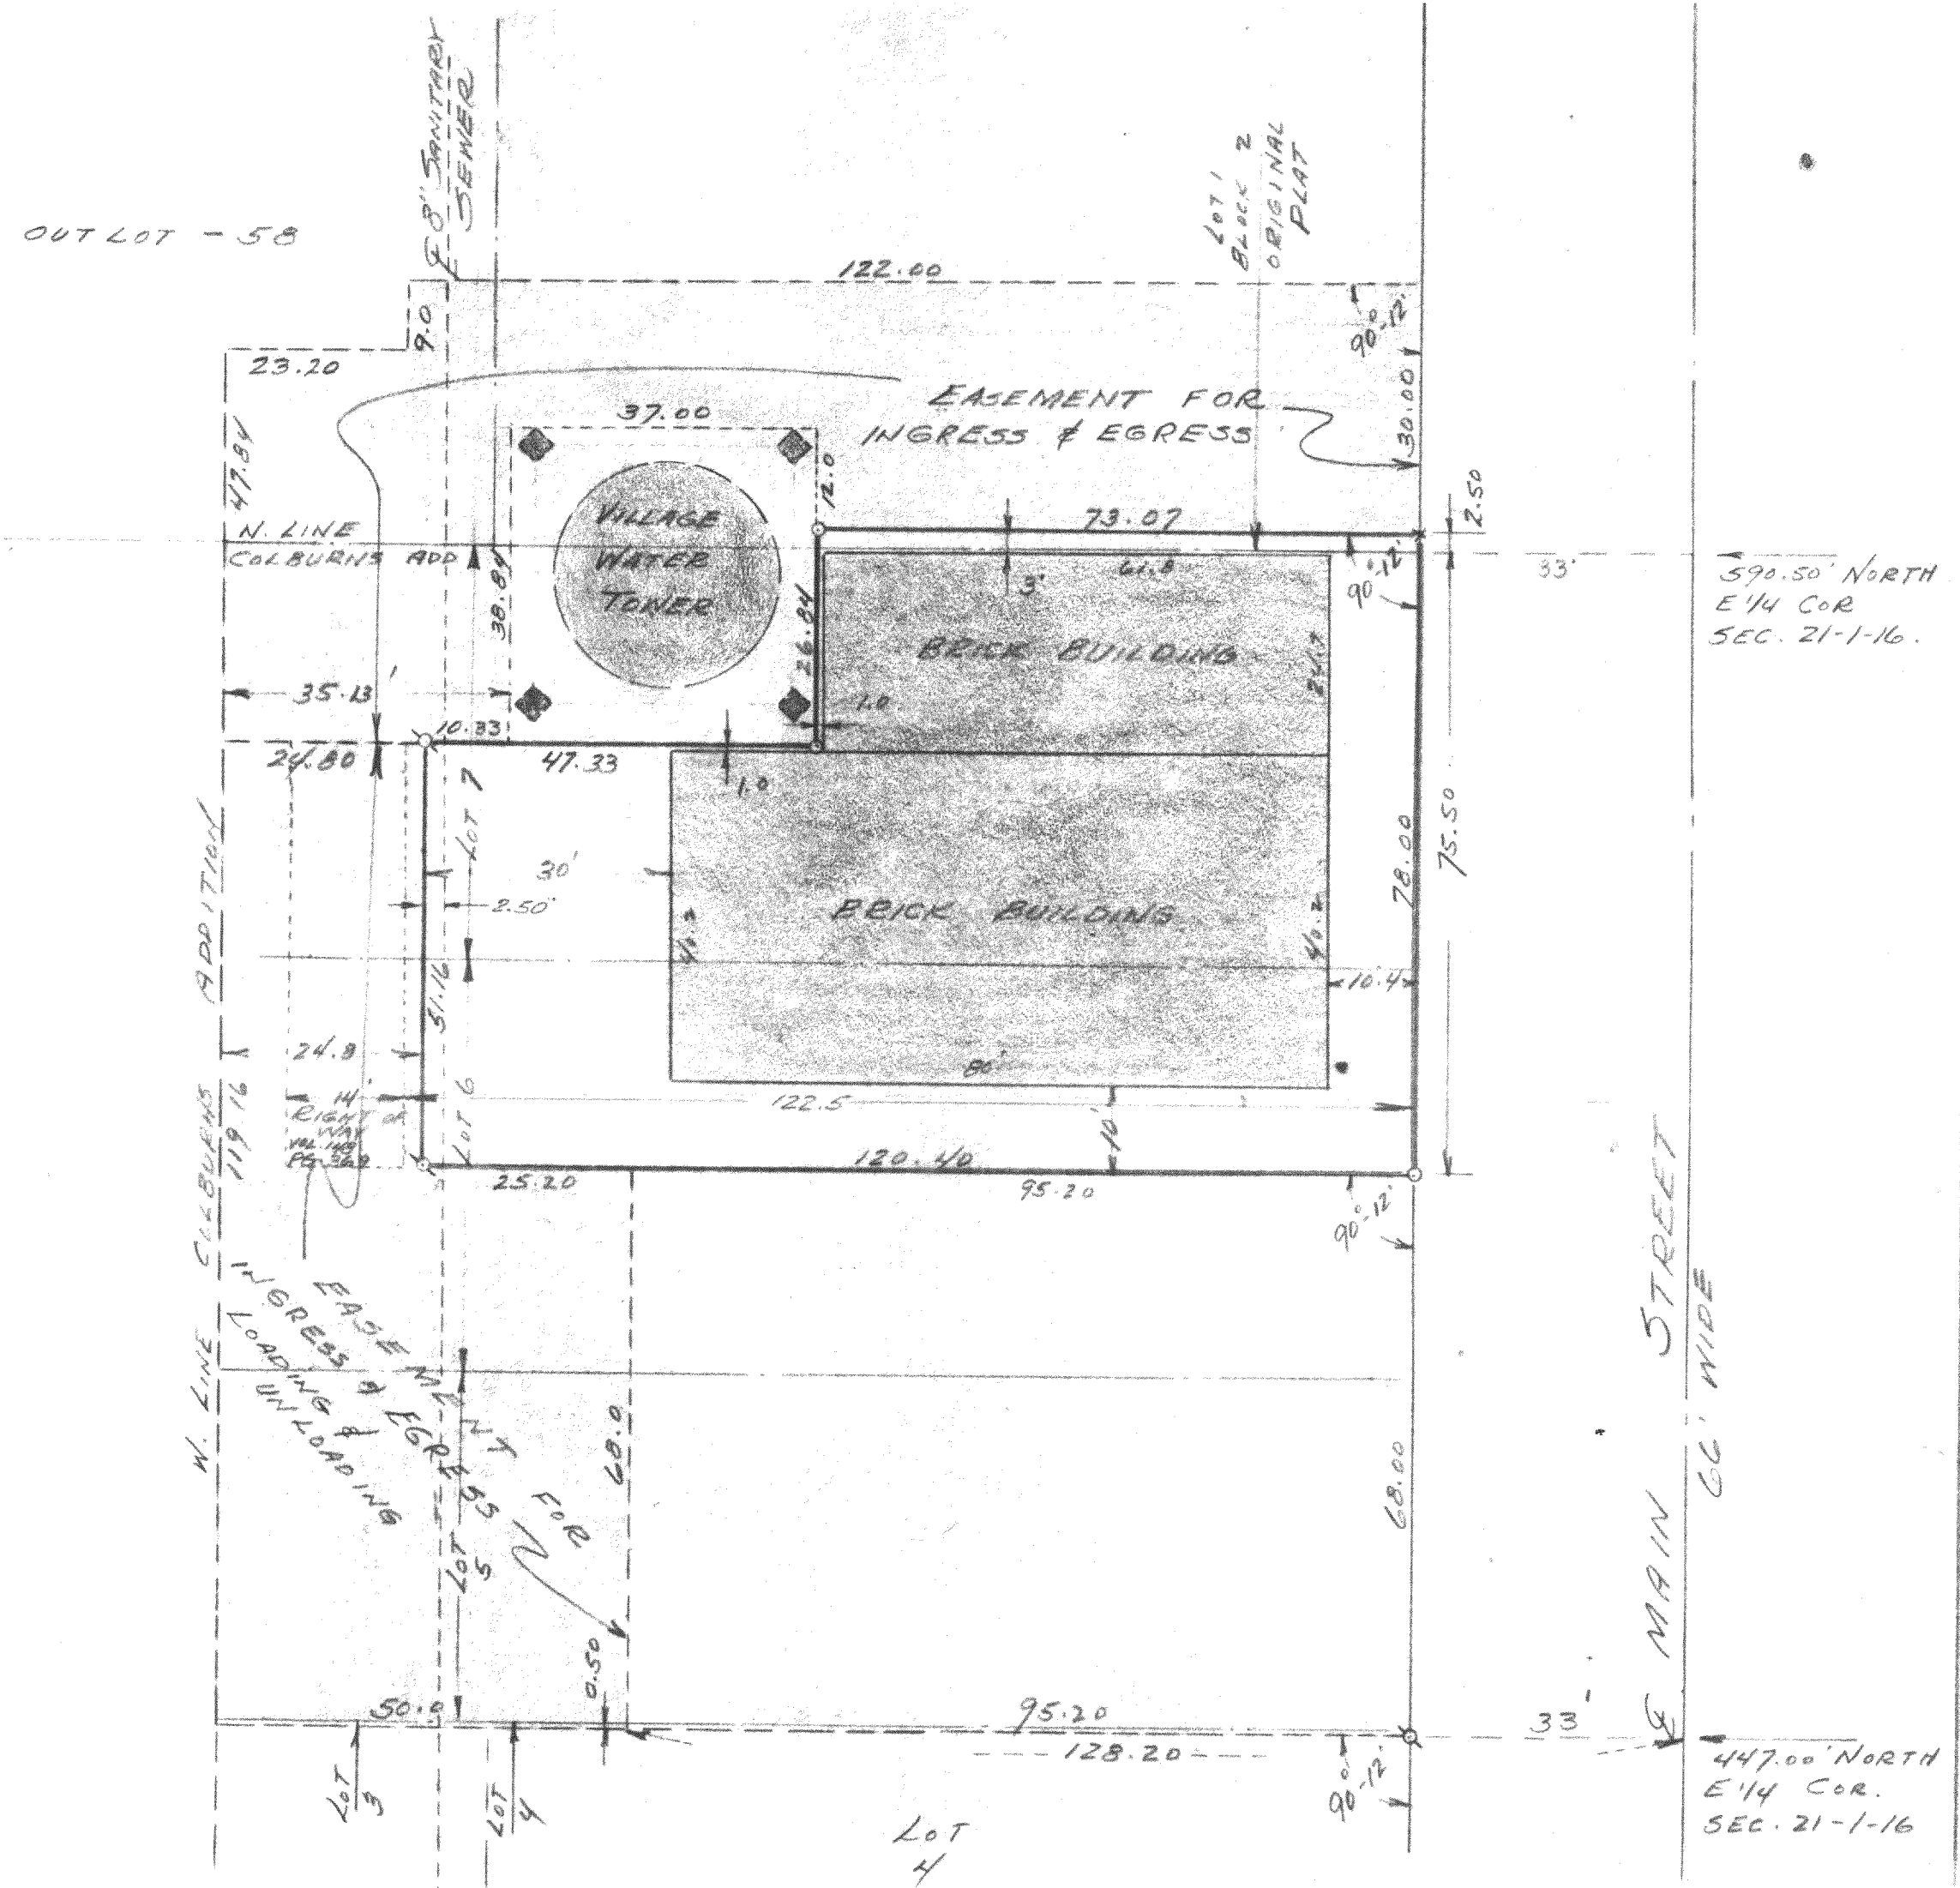

- LEGEND
- IRON PIPE
 - ⊕ RR- SPIKE
 - × P.K. NAIL

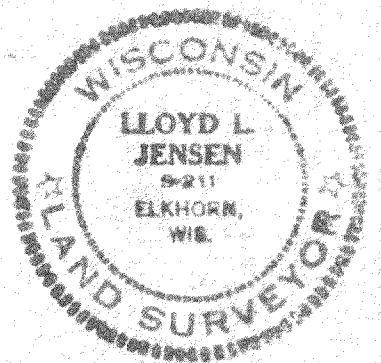

PLAT OF SURVEY
OF
LA MERE INDUSTRIES
PART OF LOTS 4-5-6-7 COLBURN'S ADD'N
PART OF OUTLOT 58 ASSESSOR'S PLAT
PART OF Lot 1 Block 2 ORIGINAL PLAT
NE 1/4 SEC. 21-1-16
WAH WORTH Co., WIS.

Lloyd L. Jensen
SURVEYOR

SCALE 1" = 20'

DATE JAN. 25, 1968

REVISED FEB. 19, 1968

REVISED MARCH 14, 1968

VCB-6 + VWP-61 + VOR-13

9-46J