FARRIS, HANSEN & ASSOCIATES, INC.

ENGINEERING, ARCHITECTURE, SURVEYING
7 RIDGWAY COURT - P.O.BOX 437, ELKHORN, WISCONSIN 53121

PHONE: (414) 723-2098 FAX: (414) 723-5886

PLAT OF SURVEY

LOT 92 OF OAK KNOLLS


ADDITION NO. 1

LOCATED IN THE SE 1/4 OF THE SE 1/4 SEC. 22

TOWN 1 NORTH, RANGE 16 EAST

VILLAGE OF WALWORTH, WALWORTH COUNTY, WISCONSIN

WORK ORDERED BY: TROY SOBERS P.O. BOX 560 FONTANA, WISCONSIN 53125

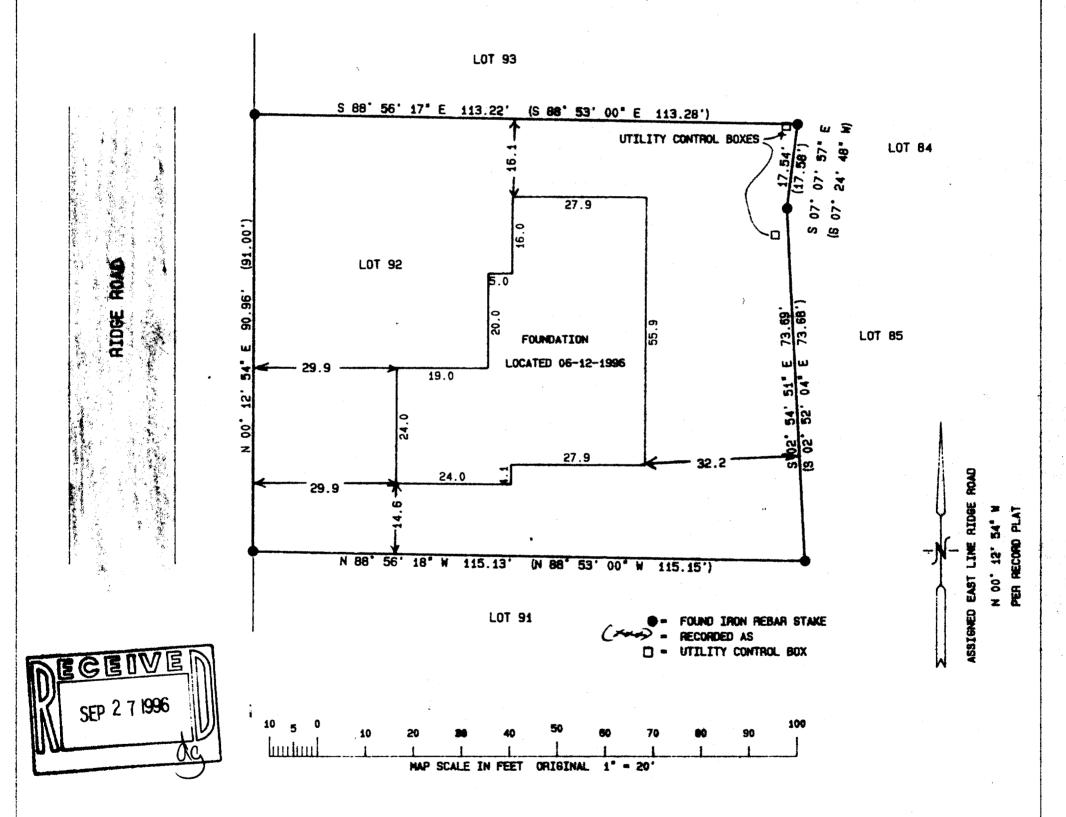

NOTE: COPIES OF THIS MAP TO WHICH THE FOLLOWING CERTIFICATE WILL APPLY ARE BLUE LINE PRINTS SHOWING SURVEYOR'S ORIGINAL SEAL AND SIGNATURE IN BLACK INK. COPIES BY ANY OTHER MEANS MAY HAVE ALTERATIONS WHICH DO NOT REPRESENT THE SURWEYOR'S MORK PRODUCT.

I HEREBY CERTIFY THAT THE ABOVE DESCRIBED PROPERTY HAS BEEN SURVEYED UNDER MY DIRECTION AND THAT THE ABOVE HAP IS A TRUE REPRESENTATION THEREOF AND SHOWS THE SIZE AND LOCATION OF THE PROPERTY AND ITS EXTERIOR BOUNDARIES. THIS SURVEY IS MADE FOR THE PRESENT SHORERS OF THE PROPERTY, AND ALSO THOSE WHO PURCHASE, NORTGAGE, OR GUARANTEE THE TITLE THERETO WITHEN ONE YEAR FRON THE DATE HEREOF.

DATED: 6-12-1996

PETER S. GORDON A.L.S. 2101

VOKI-65



PRIOU 4582 SHEET 1 OF 1