


AMERICAN SURVEYING COMPANY, INC. LAND SURVEYORS 12207 C.T.H. "K" FRANKSVILLE, WISCONSIN 53126

TEL. (414) 835-4774 FAX: (414) 835-2379

PLAT OF SURVEY

PREPARED FOR: OAK KNOLLS, LLC. DESCRIPTION:

Lot 76 of "OAK KNOLLS OF WALWORTH, ADDITION NO. 1"A, Being a resubdivision of Outlot No. 1 of "OAK KNOLLS OF WALWORTH" being a subdivision of the Southeast 1/4 of the Southeast 1/4 of Section 22, Town 1 North, Range 16 East, in the Village of Walworth, County of Walworth, State of Wisconsin.

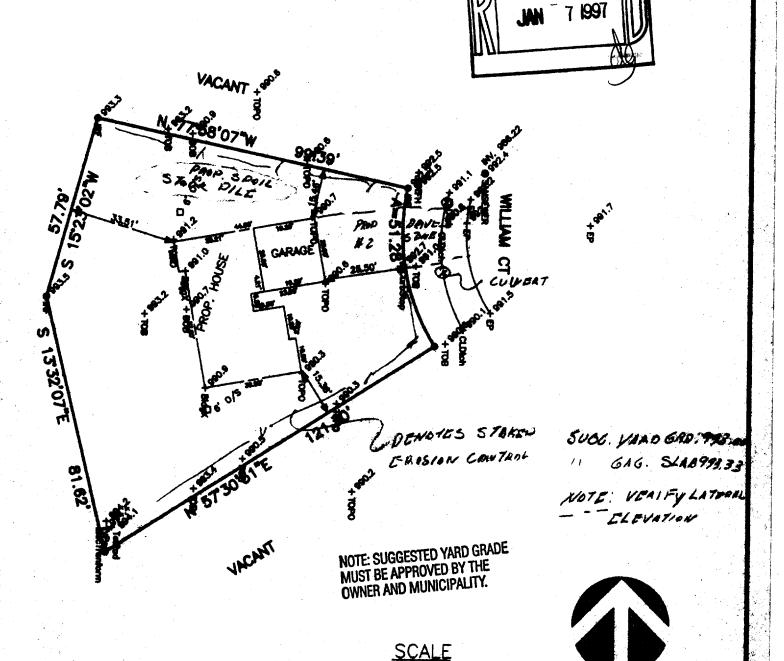

STATE OF WISCONSIN COUNTY OF RACINE

The above described property has been surveyed under my direction and the above map is a SCONSIA

30

FEET

PETE L.

BAILEY S-1398 NORTH CAPE,

SUR

Doted at NORTH CAPE , this 15TH day of AUGUST

Recertified xixxonitionononotooxxoxxxxxxxx

JOB NO. 96235 DRAWING NAME: JN89274S

009-579 VOK1-49