

ABERNATHY and ASSOCIATES

Kenneth B. Abernathy Jr.


Wisconsin Registered Land Surveyor S-1594

Rt. 3, Box 273
Elkhorn, Wisconsin 53121
Phone: (414) 723-4260 (office)
(414) 723-4813 (residence)

PLAT OF SURVEY T 22

LOT 76 OF "OAK KNOLLS OF
WALWORTH ADDITION NO. 1", BEING
A RESUBDIVISION OF OUTLOT NO. 1
OF "OAK KNOLLS OF WALWORTH",
BEING A SUBDIVISION OF THE
SOUTHEAST 1/4 OF THE SOUTHEAST
1/4 OF SECTION 22, TOWN 1
NORTH, RANGE 16 EAST, IN THE
VILLAGE OF WALWORTH, COUNTY OF
WALWORTH, STATE OF WISCONSIN.

OWNER: OAK KNOLLS, LLC
505 SPRINGRIDGE DR.
CRYSTAL LAKE, IL. 60012

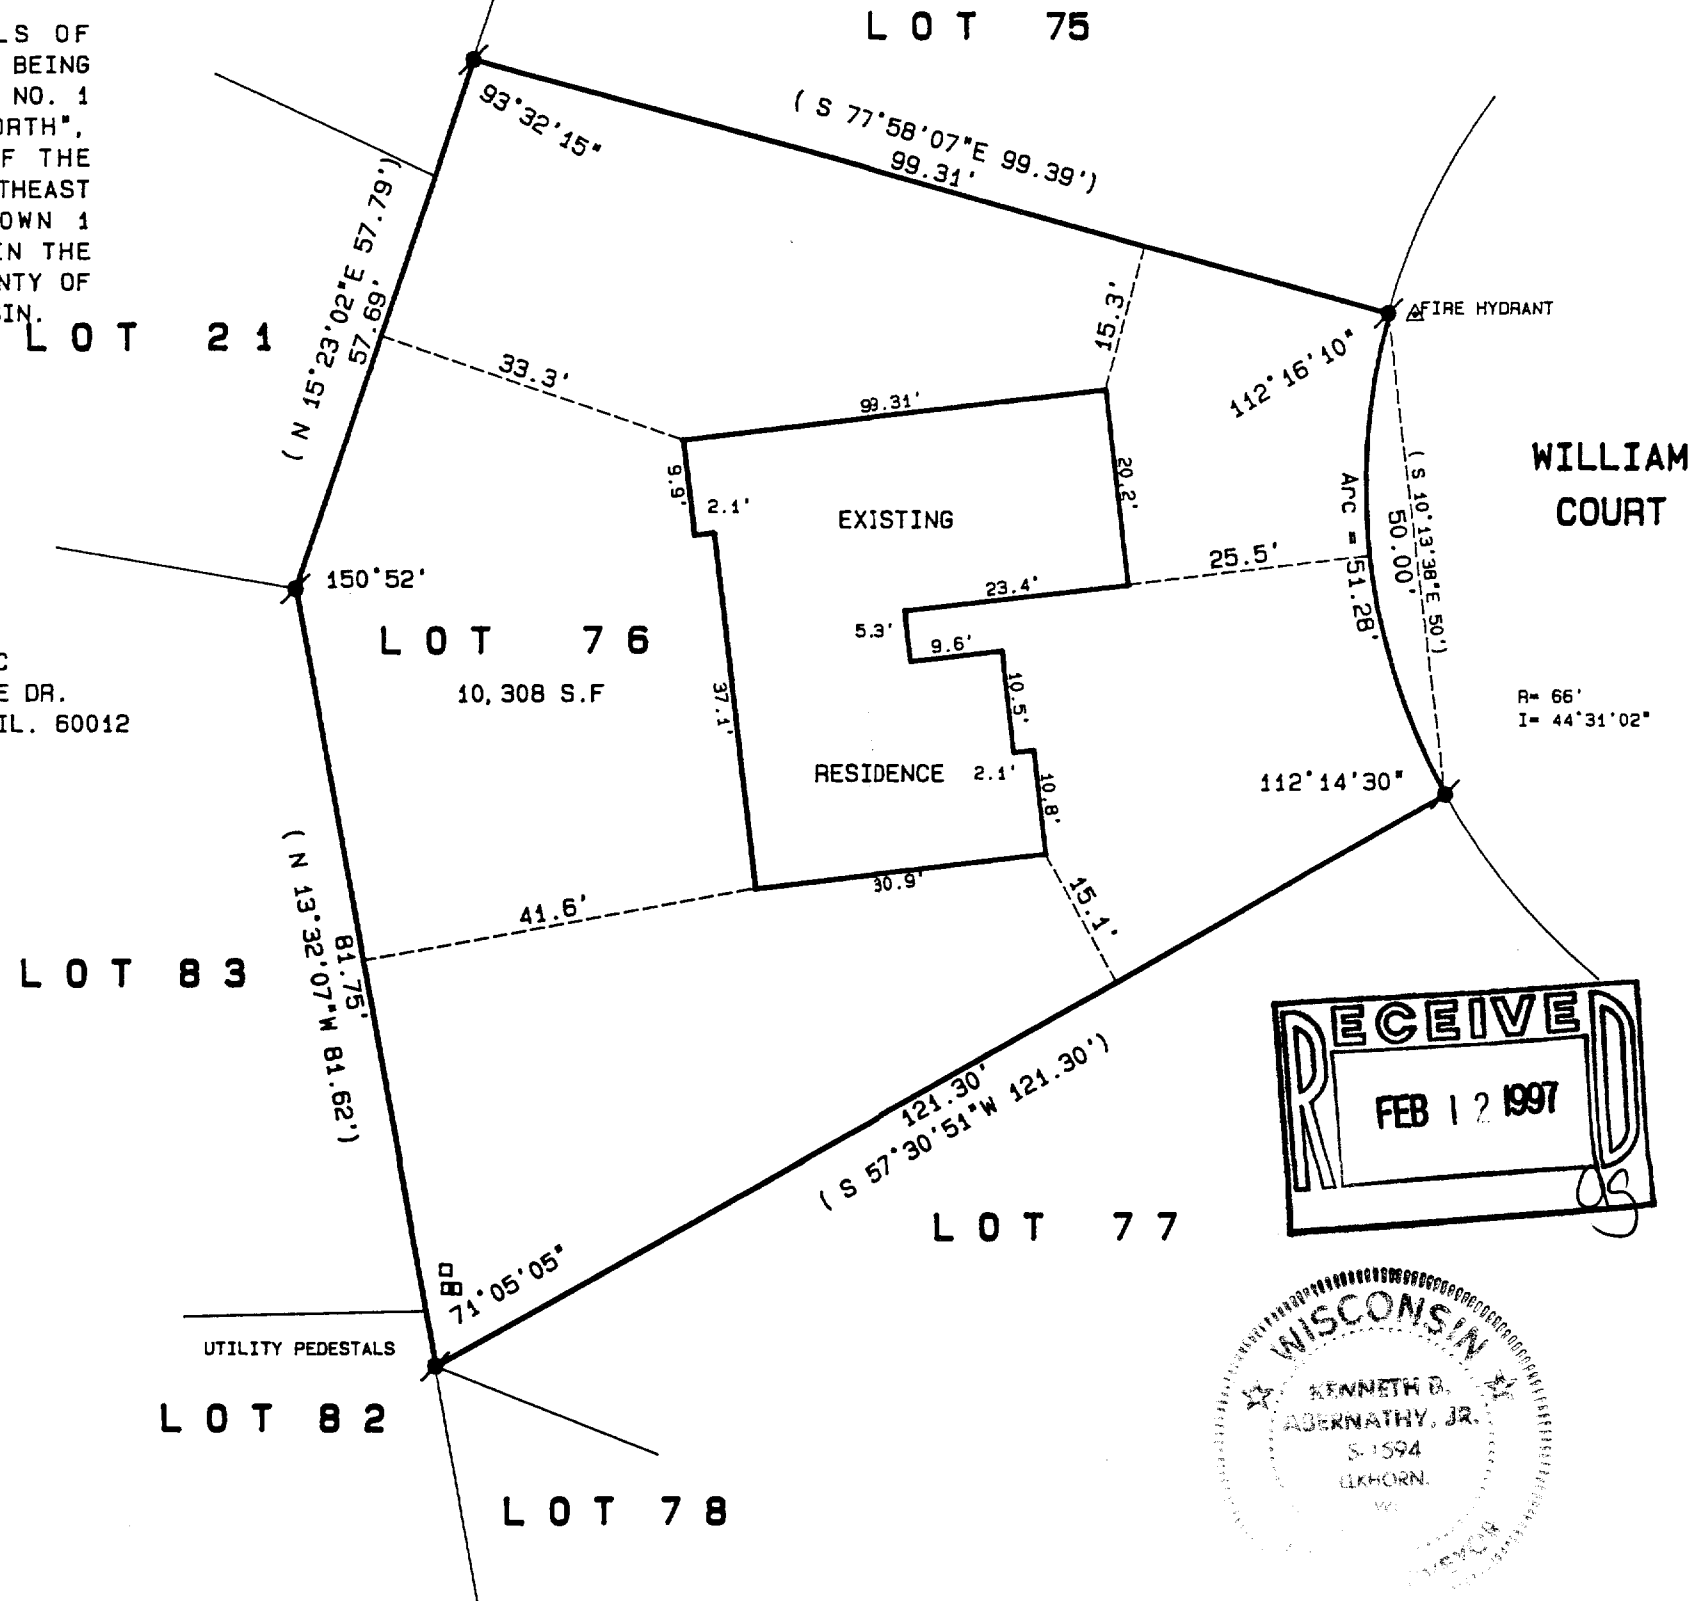

SCALE: 1" = 20 FEET

Legend

- ✕ FOUND IRON PIPE
- FOUND IRON ROD
- FOUND BRASS CAPPED MONUMENT
- FOUND CONCRETE MONUMENT
- + CHISEL CUT IN CONCRETE
- SET IRON ROD, 24" LONG, WEIGHING 1.5 LBS./LINEAL FT., 3/8" DIA.
- SET IRON ROD, 30" LONG, WEIGHING 4.5 LBS./LINEAL FT., 1-11/16" DIA.
- (xx) RECORDED AS DIMENSION
- x-x- EXISTING FENCE

"I hereby certify that I have surveyed the above described property and that the above map is a true representation thereof and shows the size and location of the property, its exterior boundaries, the location of all visible structures and dimensions of all principal buildings thereon, boundary fences, apparent easements, roadways and visible encroachments, if any."

"This survey is made for the use of the present owners of the property, and also those who purchase, mortgage, or guarantee the title thereto within one year from date hereof."

Kenneth B. Abernathy, Jr.

KENNETH B. ABERNATHY, JR.
WISCONSIN REGISTERED LAND SURVEYOR,
S-1594

Date: FEB 5, 1997 Job No. 97.203

VOKI-49

009-585