

ORDERED BY: CHURCHILL REAL ESTATE  
306A KENOSHA STREET  
WALWORTH, WI 53184


# ABELL SURVEYING & MAPPING

1140 SEQUOIA STREET • DELAVAN, WISCONSIN 53115

414-728-6737

LOT 6

SURVEYED BY LLOYD JENSEN, AUGUST 7, 1950

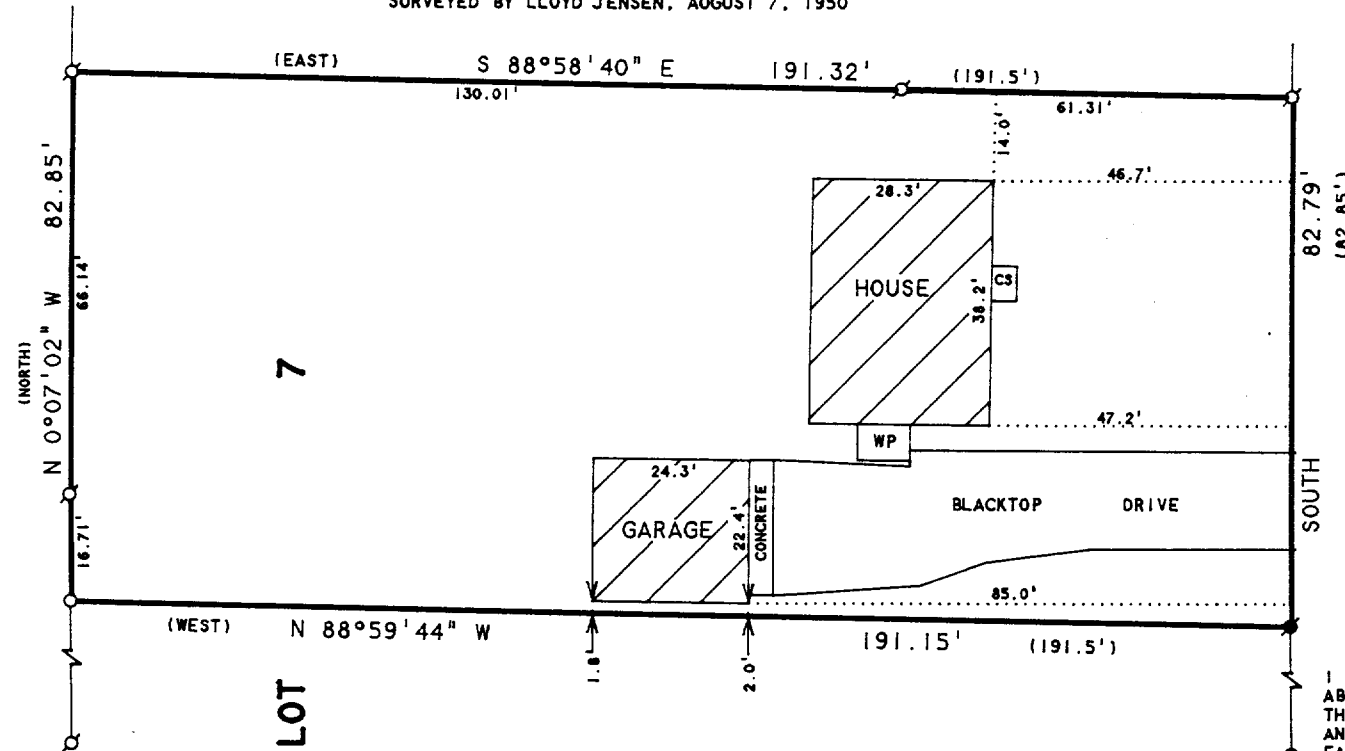

## PLAT OF SURVEY OF

BEGINNING AT THE NE CORNER OF LOT 7 OF CLARKES 2ND ADDITION,  
VILLAGE OF WALWORTH, WALWORTH COUNTY, WISCONSIN; THENCE  
SOUTH 82.85 FEET; THENCE WEST 191.5 FEET; THENCE NORTH  
82.85 FEET; THENCE EAST 191.5 FEET TO THE PLACE OF BEGINNING.

N



SCALE 1"=30'

### LEGEND

- - IRON PIPE FOUND
- - IRON ROD FOUND
- - IRON PIPE SET
- - CONCRETE MONUMENT FOUND
- ( ) - RECORDED AS
- WP - WOOD PORCH
- CS - CONCRETE STOOP

NOTE: THE BEARING ON THE EAST LINE OF LOT 7, CLARKES 2ND ADD.  
IS ASSUMED NORTH - SOUTH.

I HEREBY CERTIFY THAT I HAVE SURVEYED THE ABOVE DESCRIBED PROPERTY AND THAT THE  
ABOVE MAP IS A TRUE REPRESENTATION THEREOF AND SHOWS THE SIZE AND LOCATION OF  
THE PROPERTY, ITS EXTERIOR BOUNDARIES, THE LOCATION OF ALL VISIBLE STRUCTURES  
AND DIMENSIONS OF ALL PRINCIPAL BUILDINGS THEREON, BOUNDARY FENCES, APPARENT  
EASEMENTS, ROADWAYS AND VISIBLE ENCROACHMENTS, IF ANY, TO THE BEST OF MY  
KNOWLEDGE AND BELIEF.

THIS SURVEY IS MADE FOR THE USE OF THE PRESENT OWNERS OF THE PROPERTY, AND ALSO  
THOSE WHO PURCHASE, MORTGAGE, OR GUARANTEE THE TITLE THERETO WITHIN ONE (1) YEAR  
FROM DATE HEREON.

*David F. Abell*

DAVID F. ABELL  
WISCONSIN REGISTERED LAND SURVEYOR, S-1596

September 17, 1997

DATE: \_\_\_\_\_ JOB NUMBER - 97176  
NOTE: THIS IS NOT A CERTIFIED COPY UNLESS SEALED.

009-626

VCA2-8