ABERNATHY and ASSOCIATES

Wisconsin Registered Land Surveyor S-1594

Kenneth B. Abernathy Jr.

W4056 Bray Road Elkhorn, Wisconsin 53121 Phone: (414) 723-4260 (office) (414) 723-7269 (fax)

PLAT OF SURVEY

A PARCEL OF LAND LOCATED IN THE SOUTHEAST 1/4 OF SECTION 21, TOWN 1 NORTH, RANGE 16 EAST, VILLAGE OF WALWORTH, WALWORTH COUNTY, WISCONSIN.

A PARCEL OF LAND LOCATED IN THE SOUTHEAST 1/4 OF SECTION 21, TOWN 1 NORTH, RANGE 16 EAST, VILLAGE OF WALWORTH, WALWORTH COUNTY, WISCONSIN AS DESCRIBED IN VOL. 508, PAGE 338, DOC. NO. 205172 OF RECORDS, MORE PARTICULARLY DESCRIBED AS FOLLOWS: COMMENCE AT THE EAST 1/4 CORNER OF SAID SECTION 21; THENCE WEST ALONG THE NORTH LINE OF THE SOUTHEAST 1/4 OF SAID SECTION 21 AND THE CENTERLINE OF BELOIT STREET 1679 60 FEET TO THE POINT OF BEGINNING; THENCE S 1'28'28" E 676.57 FEET TO A FOUND IRON PIPE; THENCE N 89°58'45" E 282.02 FEET TO A FOUND CONCRETE MONUMENT; THENCE N 1°28'07" W 478.48 FEET TO A SET IRON ROD; THENCE N 89°59'37" E 436.97 FEET TO FOUND IRON PIPE; THENCE S 1'34'55" E 503.25 FEET TO A SET IRON ROD; THENCE S 89°59'17" E 244.50 FEET TO A FOUND IRON PIPE; THENCE S 1°33'02" E 449.75 FEET TO SET IRON ROD; THENCE S 89°59'50" E 270.00 FEET; THENCE S 1'29'56" E 360.91 FEET TO A SET IRON ROD; THENCE N 89 57 15" E 395.63 FEET TO A SET IRON ROD AT THE RIGHT-OF-WAY OF MAIN STREET; THENCE S 1'31'24" E ALONG SAID RIGHT-OF-WAY 939 39 TO A SET IRON ROD; THENCE S 89 50 47 W 49.99 FEET TO A SET IRON ROD; THENCE S 1 31 24" E 50 01 FEET TO A SET IRON ROD; THENCE N 89 50 47" E 100 00 FEET TO A POINT ON THE EAST LINE OF THE SOUTHEAST 1/4 OF SAID SECTION 21 AND THE CENTERLINE OF MAIN STREET; THENCE S 1'31'24" E 100.03 FEET ALONG SAID SECTION LINE AND CENTERLINE TO A FOUND BRASS CAPPED MONUMENT AT THE SOUTHEAST CORNER OF SAID SECTION 21; THENCE S 89 50 47 W ALONG THE SOUTH LINE OF THE SOUTHEAST 1/4 OF SAID SECTION 21, 2615.77 FEET TO A FOUND BRASS CAPPED MONUMENT AT THE SOUTH 1/4 CORNER OF SAID SECTION 21; THENCE N 0°34'10" W ALONG THE WEST LINE OF THE SOUTHEAST 1/4 OF SAID SECTION 21, 2174.10 FEET TO A FOUND IRON PIPE; THENCE EAST 400.00 FEET TO A FOUND IRON PIPE; THENCE N 0°34'10" W 433.00 FEET TO A POINT ON THE NORTH LINE OF THE SOUTHEAST 1/4 OF SAID SECTION 21 AND THE CENTERLINE OF BELOIT STREET; THENCE EAST ALONG SAID SECTION LINE AND CENTERLINE 492.93 FEET TO THE POINT OF BEGINNING.

TOGETHER WITH A SEWER EASEMENT DESCRIBED IN VOL. 93, PAGE 233, DOC. NO. 664833 AS FOLLOWS: THE NORTH 30 FEET OF THE SOUTH 180 FEET AND THE WEST 30 FEET OF THE SOUTHEAST 1/4 SAID SECTION 21, EXCEPTING THEREFROM THE WEST 30' OF THE NORTH 433 FEET AND EXCEPTING THEREFROM THE WEST 30' OF THE SOUTH 150 FEET.


OWNERS: PETERSON REAL ESTATE PARTNERSHIP W6219 STATE ROAD 67 WALWORTH, WI. 53184

ORDERED BY: STEVE SPIEGELHOFF

SPIEGELHOFF DEVELOPMENT L.L.C.

1120 MILL ST.

BURLINGTON, WI. 53105

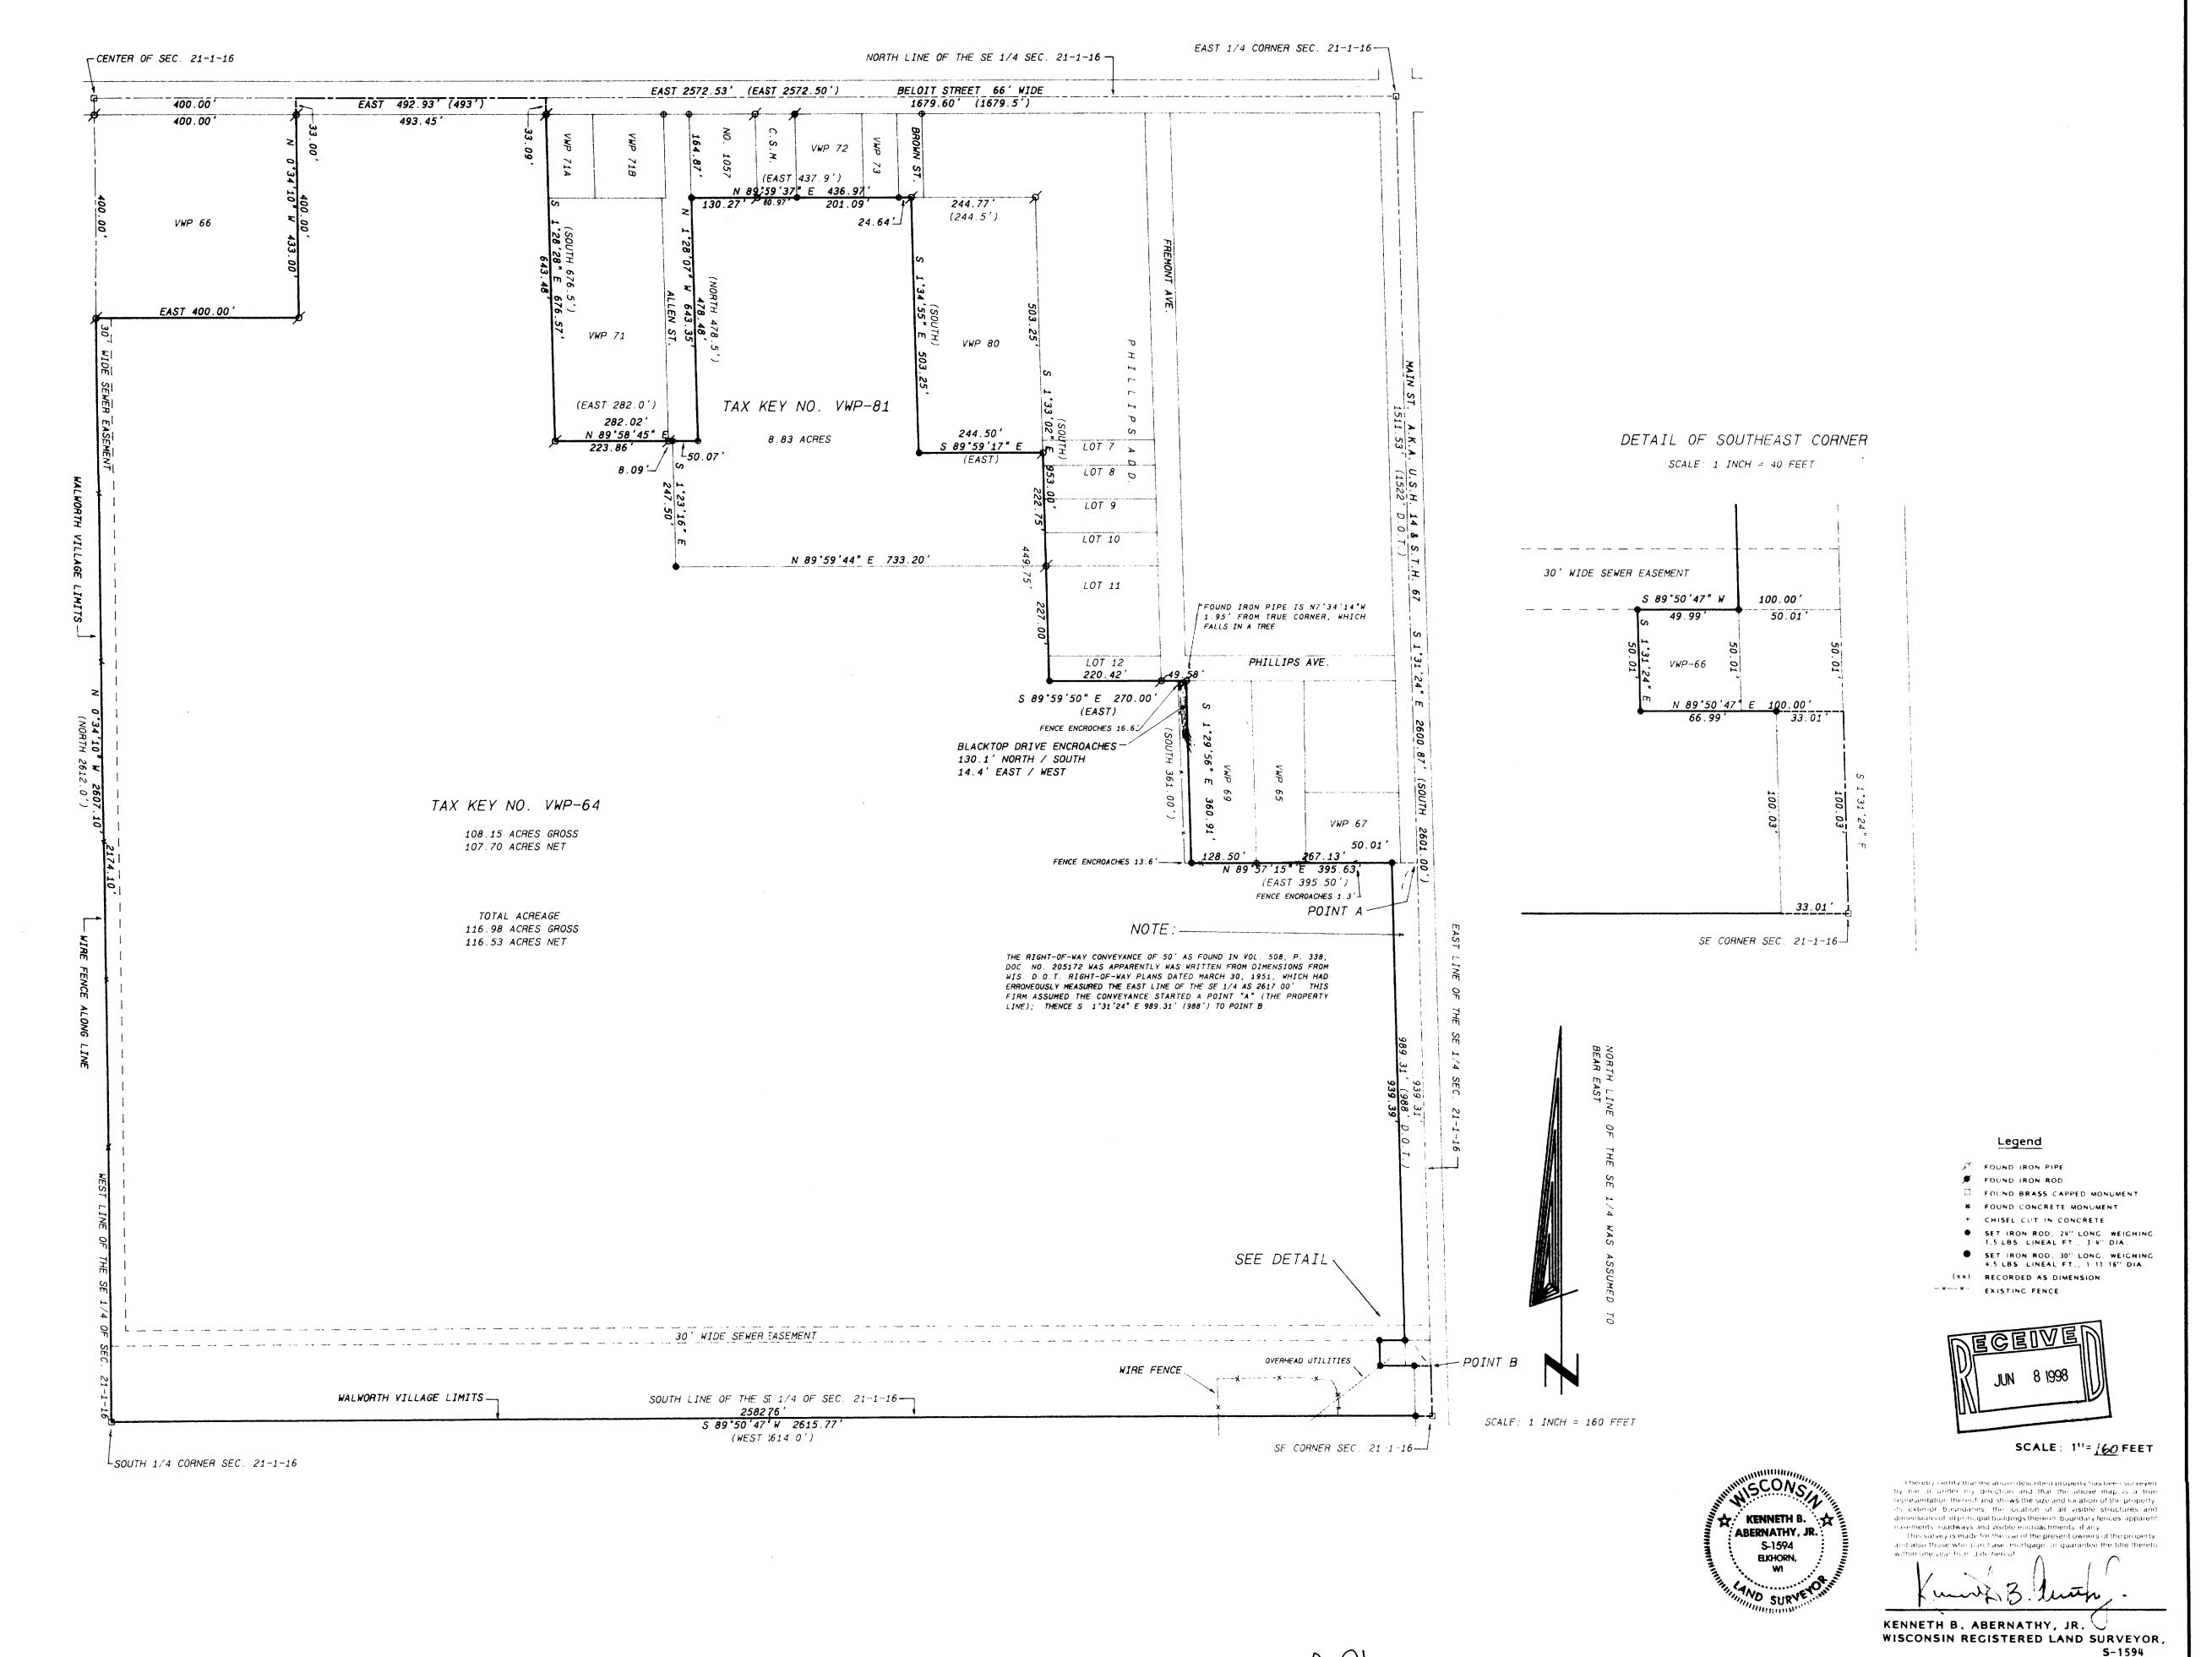

Date: 3/3/98