


# FARRIS, HANSEN & ASSOCIATES, INC.

ENGINEERING, ARCHITECTURE, SURVEYING  
7 RIDGEWAY COURT - P.O. BOX 437, ELKHORN, WISCONSIN, 53121  
PHONE: (414) 723-2098 FAX: (414) 723-5886


## PLAT OF SURVEY

LOT 6 OF OAK KNOLLS SUBDIVISION

LOCATED IN THE SE 1/4 OF THE SE 1/4  
OF SECTION 22, TOWN 1 NORTH, RANGE 16 EAST  
IN THE VILLAGE OF WALWORTH, WALWORTH COUNTY, WI

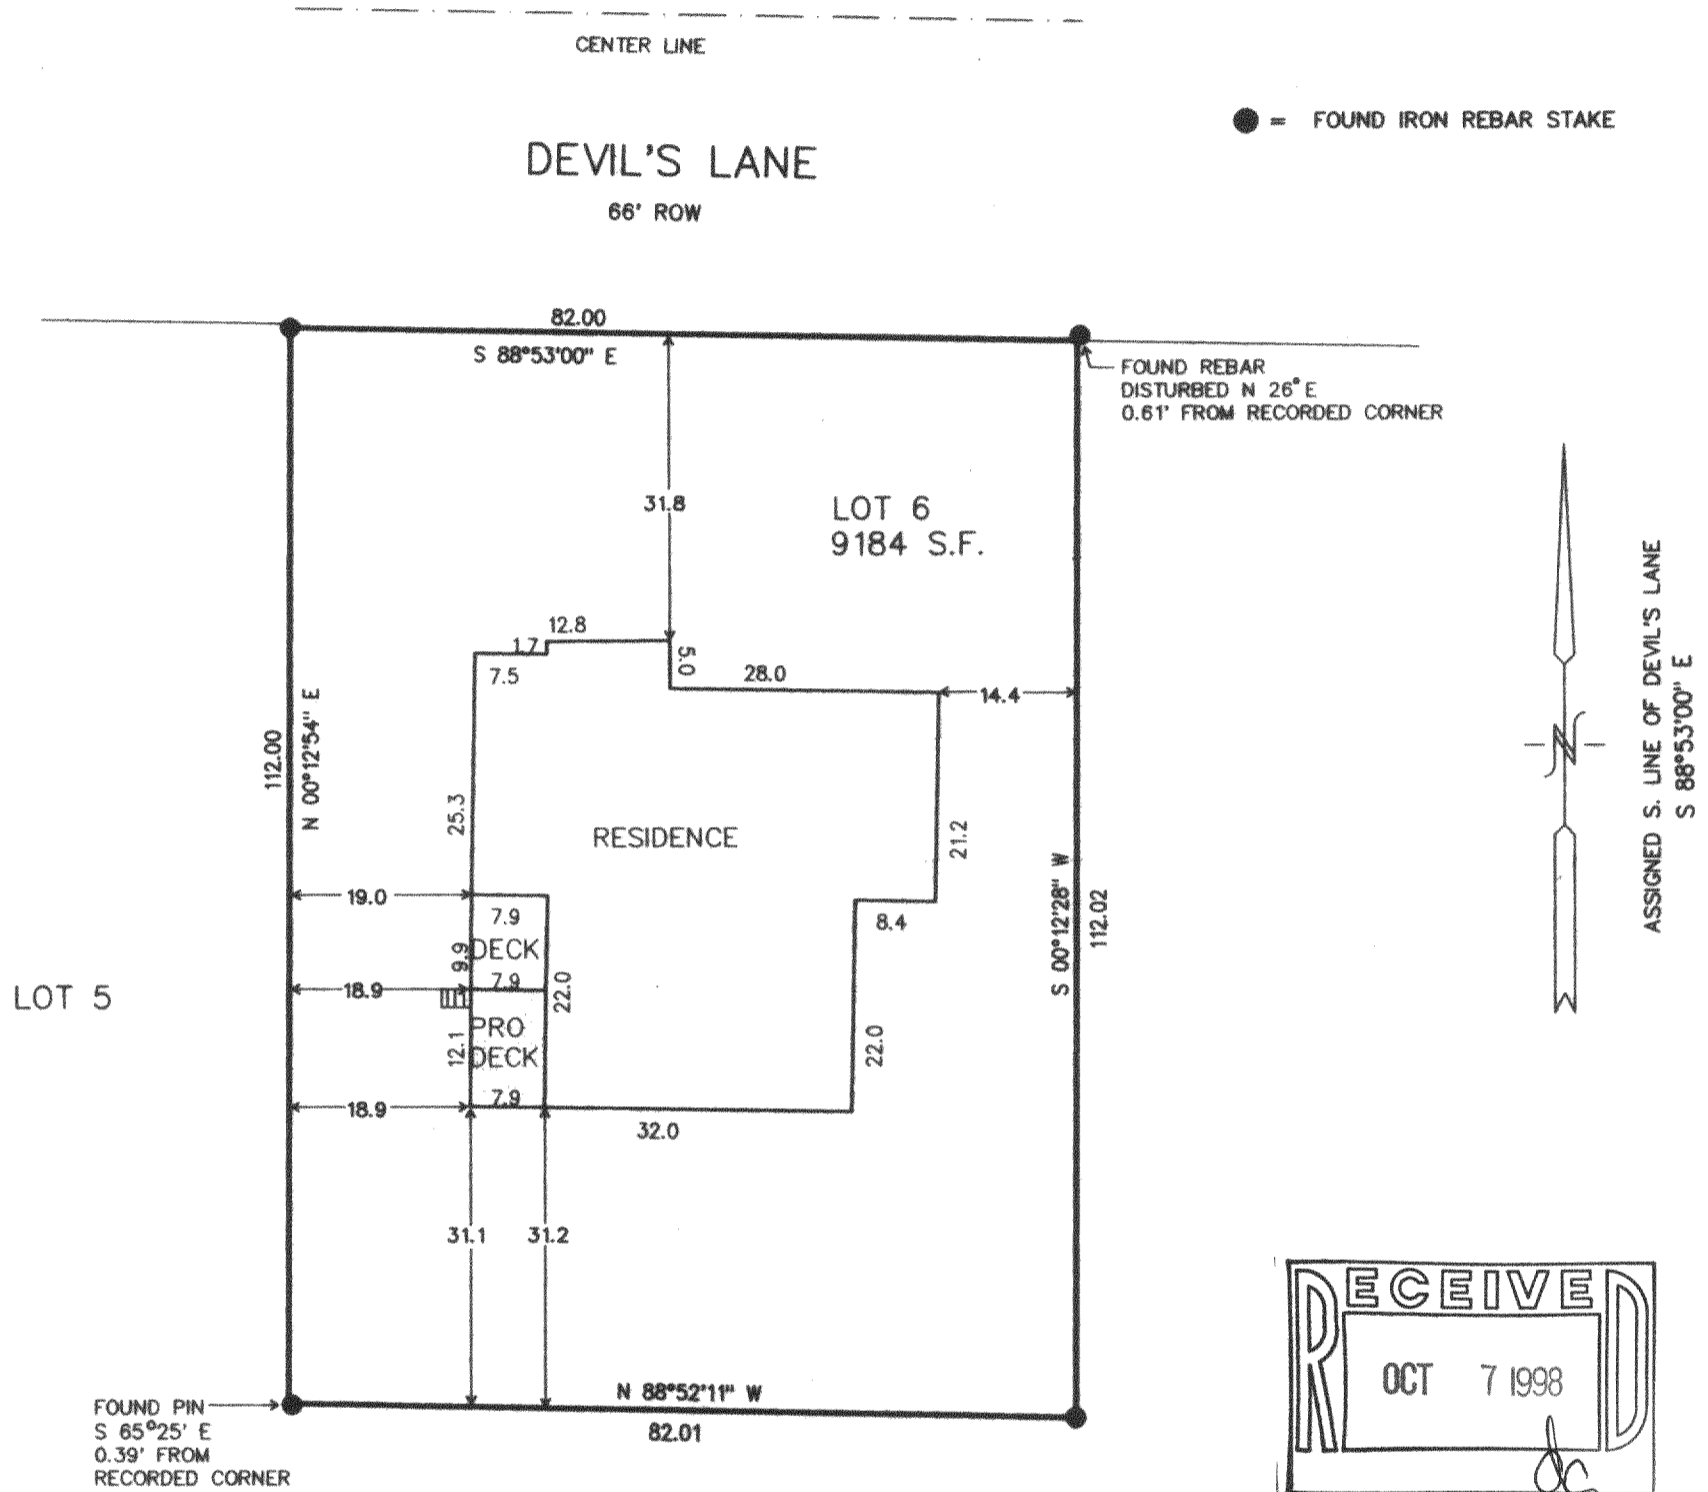

WORK ORDERED BY: MARILYN A. HALOUP  
825 DEVIL'S LANE  
WALWORTH, WI 53184

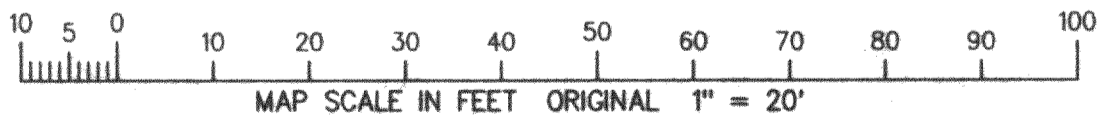


NOTE: COPIES OF THIS MAP TO WHICH THE FOLLOWING CERTIFICATE WILL APPLY ARE BLUE LINE PRINTS SHOWING SURVEYOR'S ORIGINAL SEAL AND SIGNATURE IN BLACK INK. COPIES BY ANY OTHER MEANS MAY HAVE ALTERATIONS WHICH DO NOT REPRESENT THE SURVEYOR'S WORK PRODUCT.

I HEREBY CERTIFY THAT THE ABOVE DESCRIBED PROPERTY HAS BEEN SURVEYED UNDER MY DIRECTION AND THAT THE ABOVE MAP IS A TRUE REPRESENTATION THEREOF AND SHOWS THE SIZE AND LOCATION OF THE PROPERTY AND ITS EXTERIOR BOUNDARIES. THIS SURVEY IS MADE FOR THE USE OF THE PRESENT OWNERS OF THE PROPERTY, AND ALSO THOSE WHO PURCHASE, MORTGAGE, OR GUARANTEE THE TITLE THERETO WITHIN ONE YEAR FROM THE DATE HEREOF.

DATED: 9-14-98

*Peter S. Gordon*  
PETER S. GORDON R.L.S. 2101

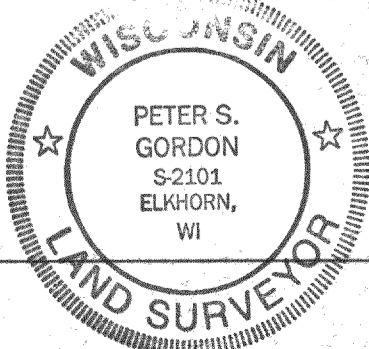

PROJECT 5113  
SHEET 1 OF 1

VOK-6  
009-656