

PLAT OF SURVEY

PATHFINDER SURVEYING
FORMERLY KOLB LAND CONSULTING
929 WILLIAMS STREET LAKE GENEVA, WI. 53147
(414) 248-3697


ORDERED BY:

MICHAEL BONNER
P.O. BOX 54
WALWORTH, WI 53184

DATE: 5 / 21 / 1999

DESCRIPTION:

A PARCEL OF LAND LOCATED IN THE SOUTHEAST 1/4 OF SECTION 21, T.1.N., R.16.E., VILLAGE OF WALWORTH, WALWORTH COUNTY, WISCONSIN, AND BEING PART OF OUTLOT 77 OF THE ASSESSORS PLAT OF THE VILLAGE OF WALWORTH, DESCRIBED AS FOLLOWS;
BEGINNING AT A POINT ON THE EAST LINE OF THE SOUTHEAST 1/4 OF SAID SECTION 21 544.60 FEET SOUTH OF THE NORTHEAST 1/4 OF THE SOUTHEAST 1/4 OF SAID SECTION 21;
THENCE S 00°00'00" E 69.50 FEET; THENCE N 88°26'43" W 198.21 FEET; THENCE N 00°07'14" E 69.49 FEET; THENCE S 88°26'49" E 198.06 FEET TO THE POINT OF BEGINNING.

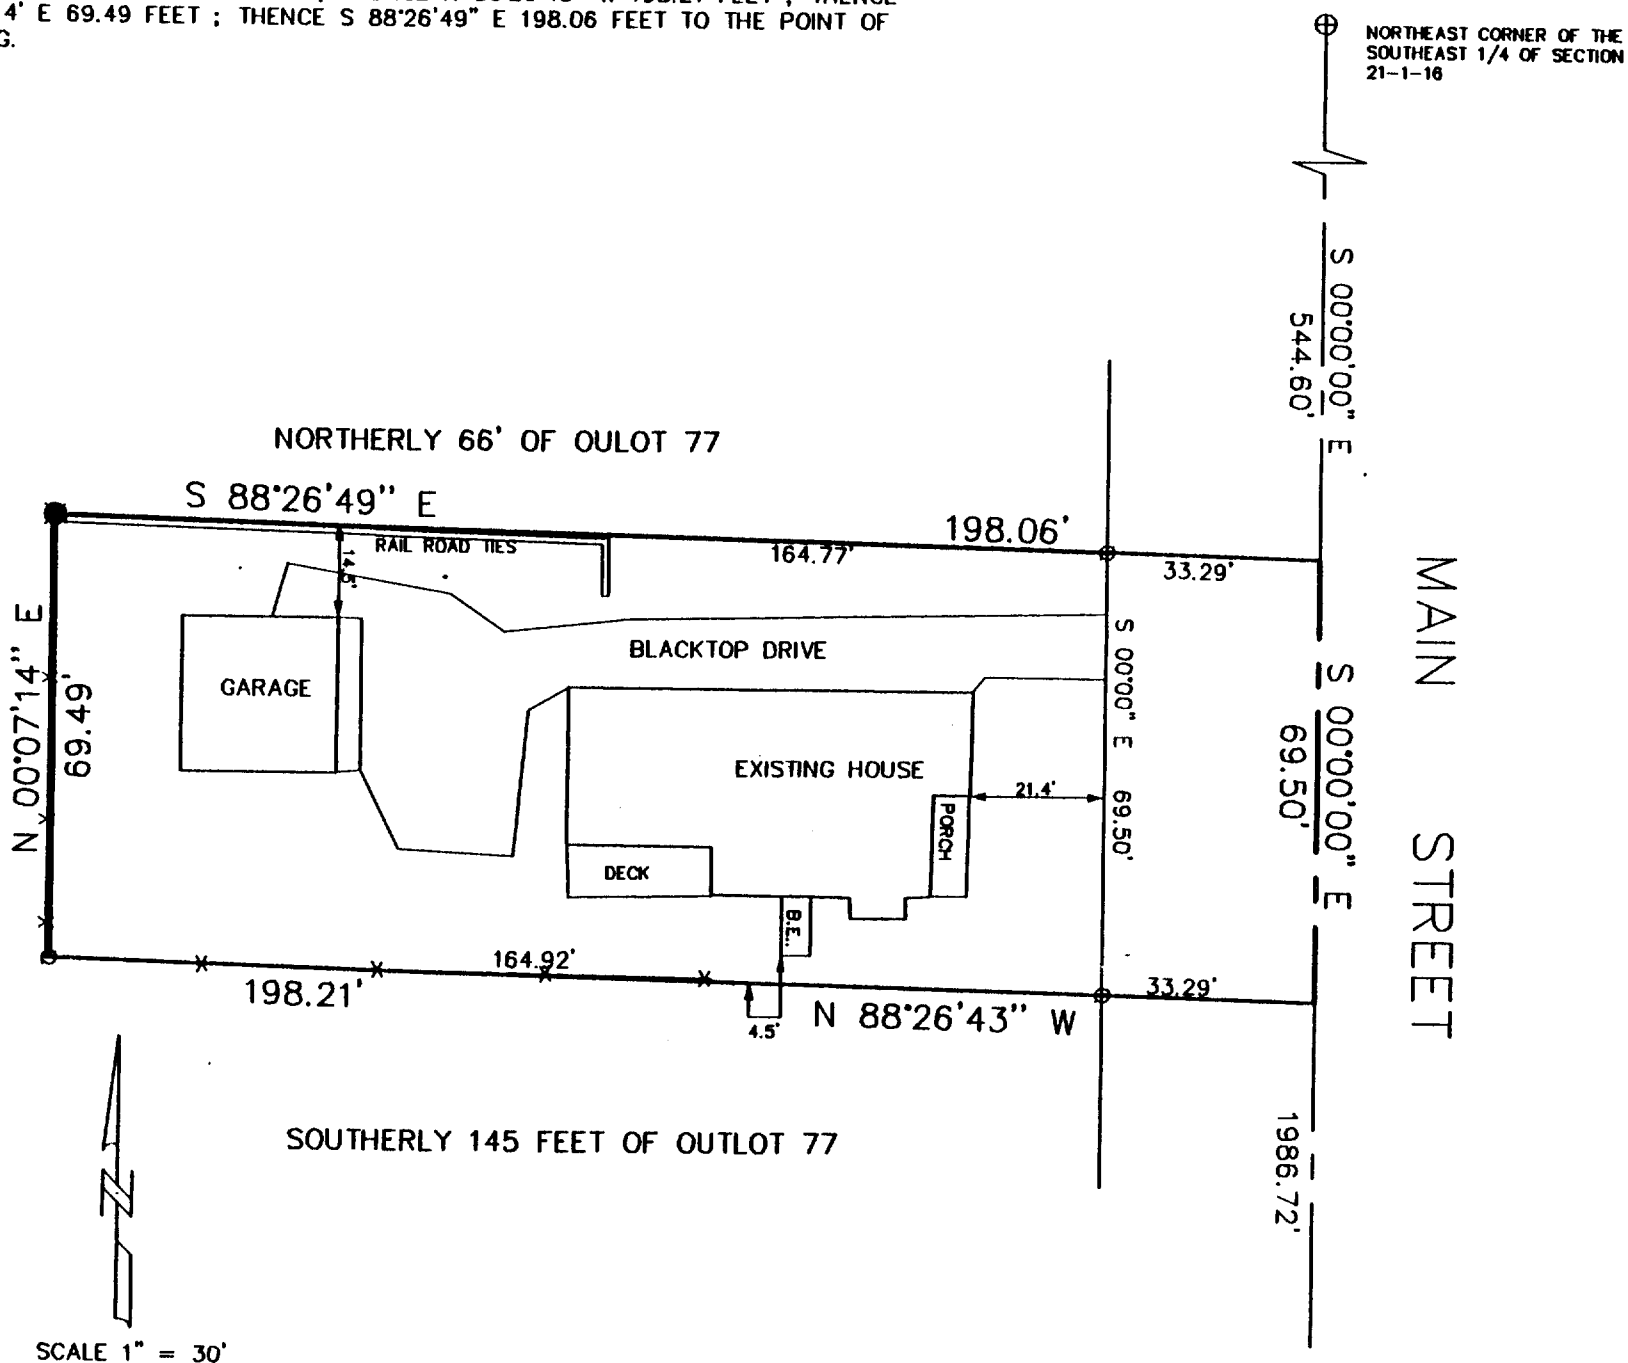


SCALE 1" = 30'

LEGEND

- FOUND IRON PIPE
- FOUND IRON PIN
- ⊕ CONCRETE MONUMENT WITH CAP
- (XXXX) RECORDED AS

THE ABOVE MAP IS A TRUE REPRESENTATION THEREOF AND SHOWS THE SIZE AND LOCATION OF ALL THE PROPERTY, EXTERIOR BOUNDARIES, THE LOCATION OF ALL VISIBLE BOUNDARY FENCES, APPARENT EASEMENTS, ROADWAYS AND VISIBLE ENCROACHMENTS, IF ANY

THIS SURVEY IS MADE FOR THE USE OF THE PRESENT OWNERS OF THE PROPERTY, AND ALSO THOSE WHO PURCHASE, MORTGAGE OR GUARANTEE TITLE THERETO WITHIN ONE (1) YEAR FROM DATE HERETO.

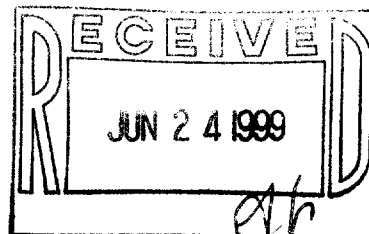

JOHN P. KROTT, R.L.S. 2258

NOTE: THIS IS NOT A CERTIFIED COPY UNLESS SEAL IS IN RED.

JOB NUMBER: 99113 WAL-VMPO0088

009-685

VWP-88