
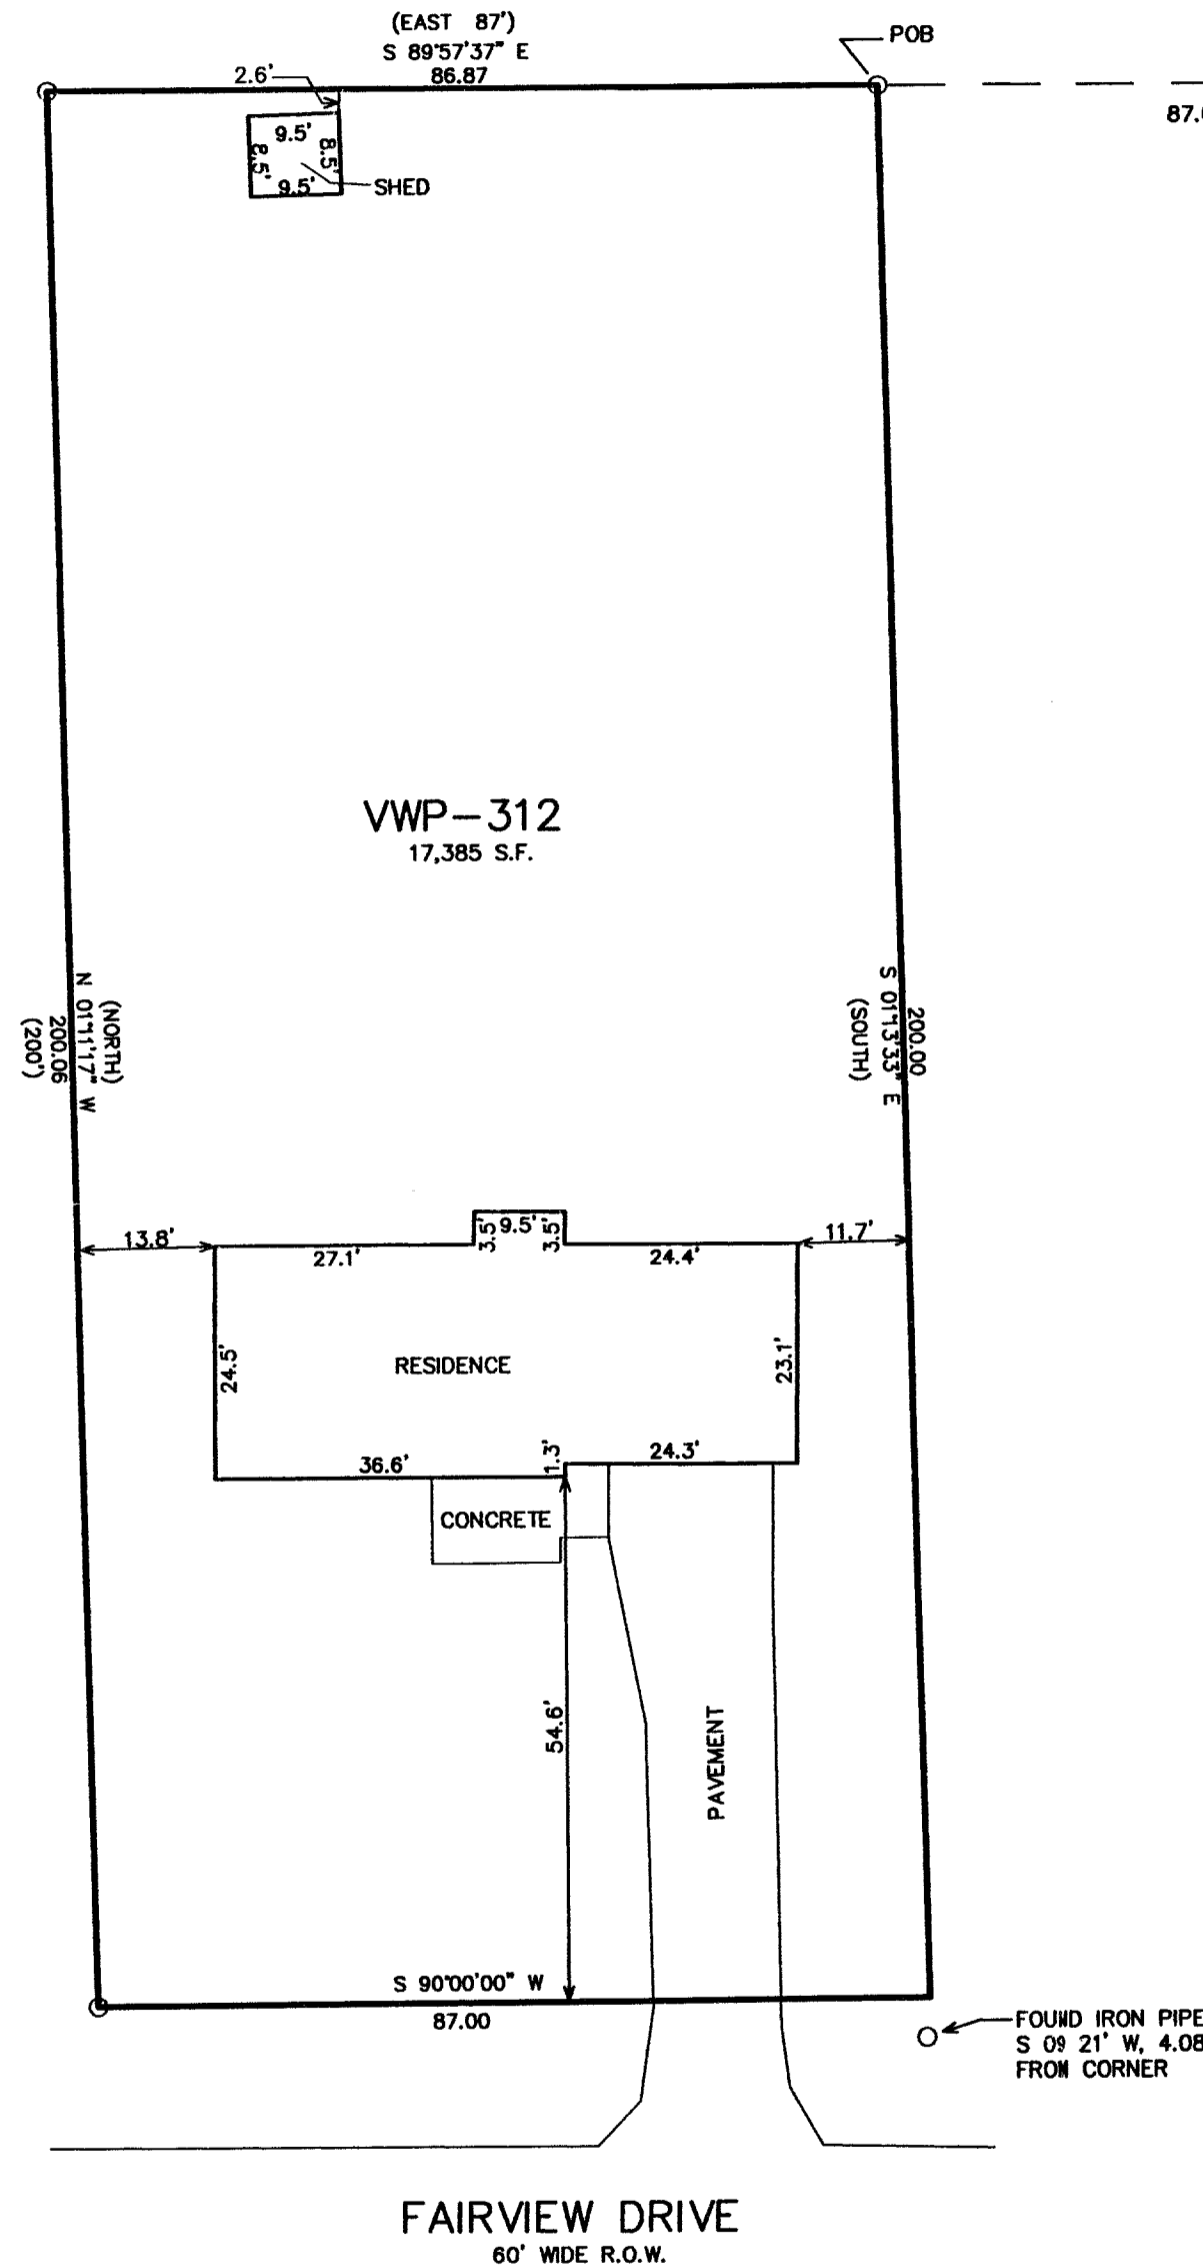


WORK ORDERED BY -  
ART ANDERSON  
W 6242 STATELINE ROAD  
WALWORTH, WI 53184

FARRIS, HANSEN & ASSOCIATES, INC.  
ENGINEERING - ARCHITECTURE - SURVEYING  
7 RIDGWAY COURT P.O. BOX 437  
ELKHORN, WISCONSIN 53121  
OFFICE: (262) 723-2098 FAX: (262) 723-5886

REVISIONS  
06/23/02  
TO SHOW REV.  
SHED KJD

PROJECT NO.  
6048  
DATE:  
06/04/02  
SHEET NO.  
1 OF 1

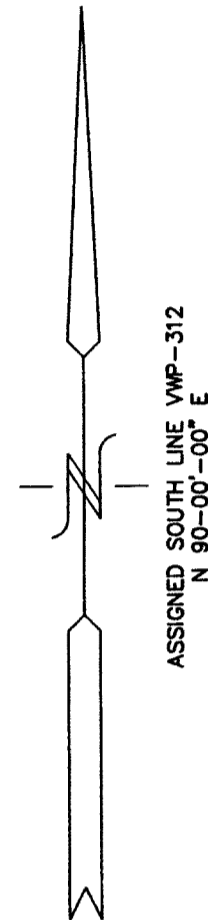

# PLAT OF SURVEY

## PART OF OUTLOT 222 OF THE VILLAGE OF WALWORTH

### LEGAL DESCRIPTION:


PART OF OUTLOT 222 OF ASSESSORS PLAT FOR THE VILLAGE OF WALWORTH; LOCATED IN THE SOUTHWEST 1/4 OF THE SOUTHWEST 1/4 OF SECTION 22, TOWN 1 NORTH, RANGE 16 EAST, WALWORTH COUNTY WISCONSIN, DESCRIBED AS FOLLOWS:  
COMMENCING 258 FEET SOUTH AND 434 FEET EAST OF THE NORTHWEST CORNER OF THE SOUTHWEST 1/4 OF THE SOUTHWEST 1/4 OF SAID SECTION 22, TOWN 1 NORTH, RANGE 16 EAST; THENCE 200 FEET SOUTH; THENCE 87 FEET WEST; THENCE 200 FEET NORTH; THENCE 87 FEET EAST TO THE POINT OF BEGINNING.

NOTE: COPIES OF THIS MAP TO WHICH THE FOLLOWING CERTIFICATE WILL APPLY SHOW SURVEYOR'S ORIGINAL SEAL AND SIGNATURE IN RED INK. COPIES BY ANY OTHER MEANS MAY HAVE ALTERATIONS WHICH DO NOT REPRESENT THE SURVEYOR'S WORK PRODUCT.

I HEREBY CERTIFY THAT THE ABOVE DESCRIBED PROPERTY HAS BEEN SURVEYED UNDER MY DIRECTION AND THAT THE ABOVE MAP IS A TRUE REPRESENTATION THEREOF AND SHOWS THE SIZE AND LOCATION OF THE PROPERTY, ITS EXTERIOR BOUNDARIES, THE LOCATION OF ALL VISIBLE STRUCTURES, AND DIMENSIONS OF ALL PRINCIPLE BUILDINGS THEREON, BOUNDARY FENCES, APPARENT EASEMENTS, ROADWAYS, AND VISIBLE ENCROACHMENTS, IF ANY. THIS SURVEY IS MADE FOR THE USE OF THE PRESENT OWNERS OF THE PROPERTY, AND ALSO THOSE WHO PURCHASE, MORTGAGE, OR GUARANTEE THE TITLE THERETO WITHIN ONE YEAR FROM THE DATE HEREOF.

DATED: JUNE 23, 2002

PETER S. GORDON R.L.S. 2101

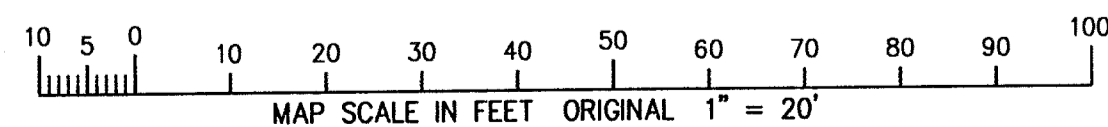

VWP-312 009-802

