
PLAT OF SURVEY

-OF-

J.K. SURVEYING INC. N3705 WILLOWBEND LANE LAKE GENEVA, WI, 53147 262-248-3697

PREPARED FOR: RAULAND AGENCY INC 118 KENOSHA ST. P.O. BOX 159 WALWORTH, WI 53184

THE EAST 60 FEET OF LOT 19, PHILLIPS ADDITION TO THE VILLAGE OF WALWORTH, WALWORTH COUNTY, WISCONSIN.

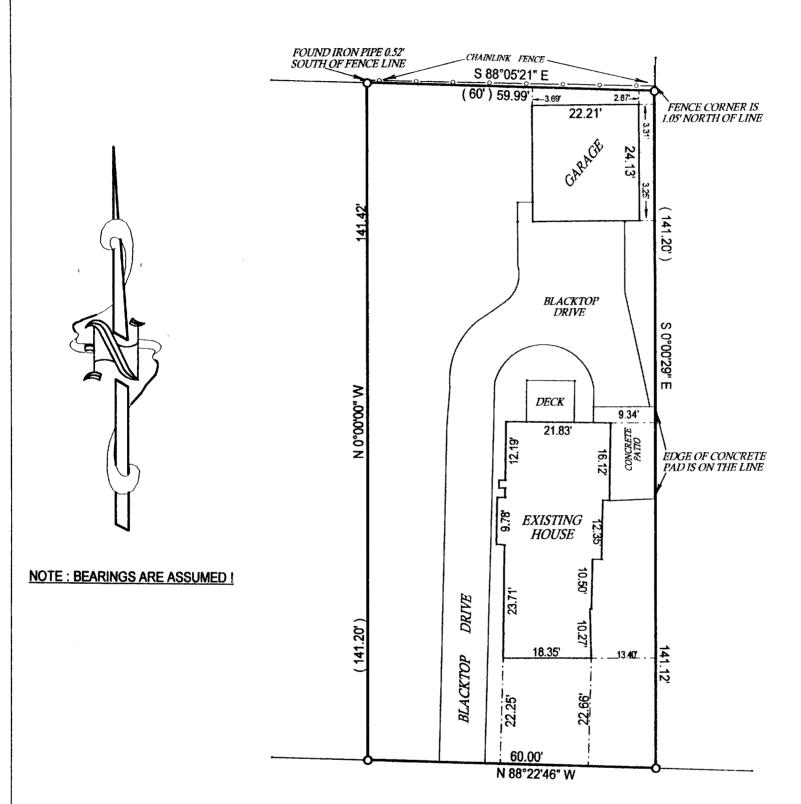

PHILLIPS STREET

(49.5' WIDE AS PLATTED)

DEC 1 7 2002

DH

() = recorded as

= found iron bar

O= found iron pipe

= set iron pipe

== set iron bar

SCALE 1" = 20'

JOB # 02-505

TAX ID # VPA 00014


COMPARE LEGAL DESCRIPTION ABOVE AND DRAWING WITH DEED. FOR BUILDING RESTRICTIONS AND EASEMENTS NOT SHOWN, REFER TO DEED, ABSTRACT SOURCES AND LOCAL MUNICIPAL CODES. NOTIFY THE SURVEYOR IMMEDIATELY OF ANY DISCREPANCY.

"I hereby certify that the above described property was surveyed under my supervision and that the above map is a true representation thereof and shows the size and location of all visible structures, apparent easements and encroachments if any."

This survey is made for the present owners of the property, and those who purchase, mortgage, or guarentee the title thereto, within one year from

the date hereof.

DATED THIS <u>08</u> TH, DAY OF <u>OCTOBER</u> 20 <u>02</u> .

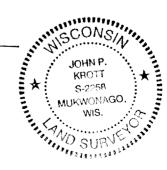

JOHN KROTT S - 2258
Wisconsin Registered Land Surveyor
(original if signed in red)