
PREPARED FOR: JOE BALSITIS 227 DEWEY AVE FONTANA, WI 53125

## PLAT OF SURVEY

J.K. SURVEYING INC. N3705 WILLOWBEND LANE LAKE GENEVA, WI, 53147 262-248-3697

- OF -

LOT 44, OAK KNOLLS OF WALWORTH ADDITION NO. 1, A RESUBDIVISION OF OUT LOT 1 OF OAK KNOLLS OF WALWORTH, BEING A SUBDIVISION OF THE SOUTHEAST 1/4 OF THE SOUTHEAST 1/4 OF SECTION 22, TOWN 1 NORTH, RANGE 16 EAST, IN THE VILLAGE OF WALWORTH, COUNTY OF WALWORTH, STATE OF WISCONSIN.

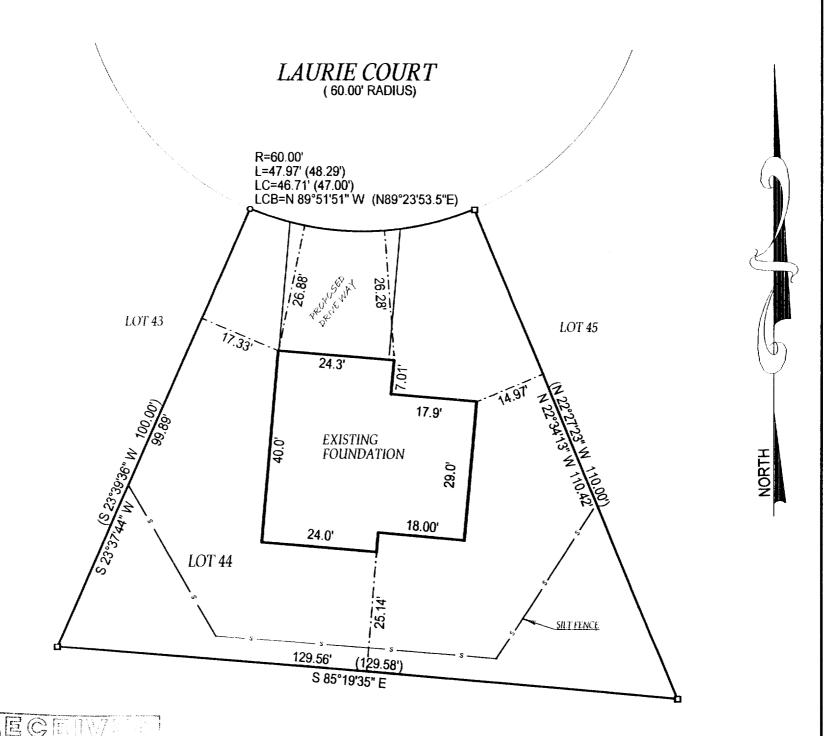

( )= recorded as

DEC 2 6 2002

= found iron bar

= found iron pipe

- set iron pipe

= set iron bar

SCALE 1" = 20"

JOB # 01-109AB **TAX ID # VOK1-17**  DATE OF LAST REVISION: 12 / 18 / 2002 REVISED: 08 / 27 / 2002

REVISED: 08 / 23 / 2002 REVISED: 6 / 12 / 2001

COMPARE LEGAL DESCRIPTION ABOVE AND DRAWING WITH DEED. FOR BUILDING RESTRICTIONS AND EASEMENTS NOT SHOWN, REFER TO DEED, ABSTRACT SOURCES AND LOCAL MUNICIPAL CODES. NOTIFY THE SURVEYOR IMMEDIATELY OF ANY DISCREPANCY

"I hereby certify that I have surveyed the above described property and that the above map is a true representation thereof and shows the size and location of all visible structures, apparent easements and encroachments

This survey is made for the present owners of the property, and those who purchase, mortgage, or guarantee the title thereto, within one year from the date hereof.

DATED THIS

TH, DAY OF APRIL 20 01

1 YOK1 - 17

MUKWO WIS. JOHN KROTT S - 2258

William Scower

(original if signed in red)

Wisconsin Registered Land Surveyor