


**SURVEYING & SUBDIVIDING
DELAN, WISCONSIN 53115**

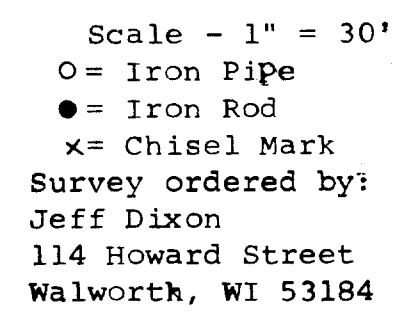

the property described as follows:

The East ½ of Outlot 92 of the Assessors Plat of the Village of Walworth, Walworth County, Wisconsin,
AND that the information of the survey of the West ½ of Outlot 94 is from the plat of survey of the West ½ of Outlot 94, Assessors Plat, Village of Walworth, Walworth Co. Wisconsin, dated June 3, 1978 and signed by Thomas P. A. Jensen, Surveyor, Elkhorn, WI.

and that the map shown above is a true representation thereof and shows the size and location of the property, its exterior boundaries, apparent easements, roadways and visible encroachments, if any, and that I have surveyed the property hereon described, according to the official records, to the best of my knowledge and belief.

March 17, 2003

RECEIVED
MAY 9 2003

