
DUNHAM SURVEYING, S.C. SURVEYING & SUBDIVIDING DELAYAN, WISCONSIN 53115

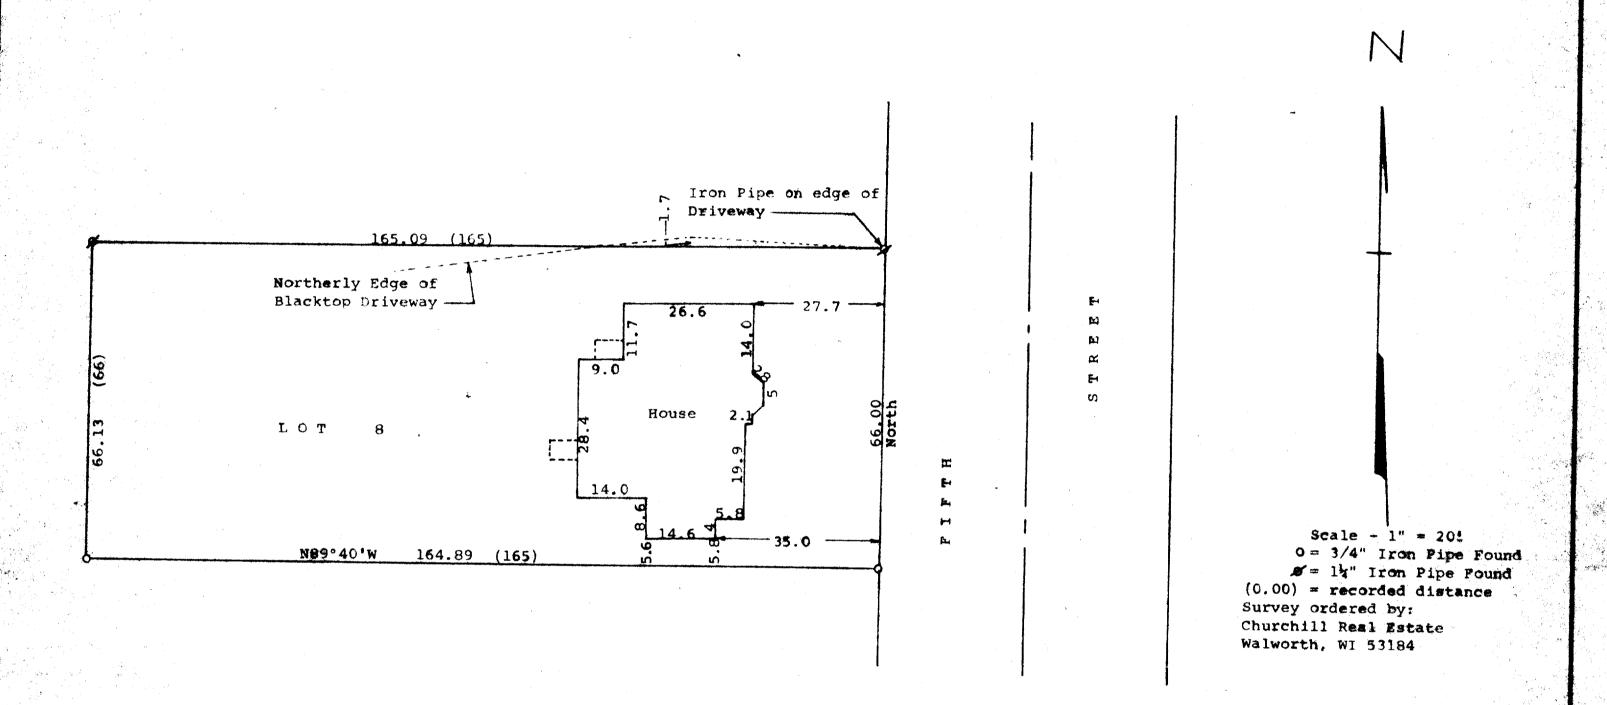

STATE OF WISCONSIN) SS


I, George T. Dunham, Surveyor, certify that I have surveyed the property described as follows:

Lot 8, Block 1 of E. W. Crumbs Addition to the Village of Walworth, Walworth County, Wisconsin

and that the

plat shown hereon is a correct representation thereof and shows the size and location of the property, its exterior boundaries, the location of all visible structures and dimensions of all principal buildings thereon, boundary fences, apparent easements, roadways and visible encroachments, if any, and that I have surveyed the property hereon described, according to the official records, to the best of my knowledge and belief. April 9, 1999

George T. Dunham, Surveyor

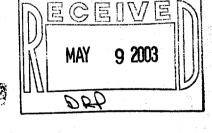

MINIMAN ON BUILD

GEORGE T. DUNHAM S-306