
HAROLD H. KOLB

REGISTERED PROFESSIONAL LAND SURVEYOR LAKE GENEVA, WISCONSIN



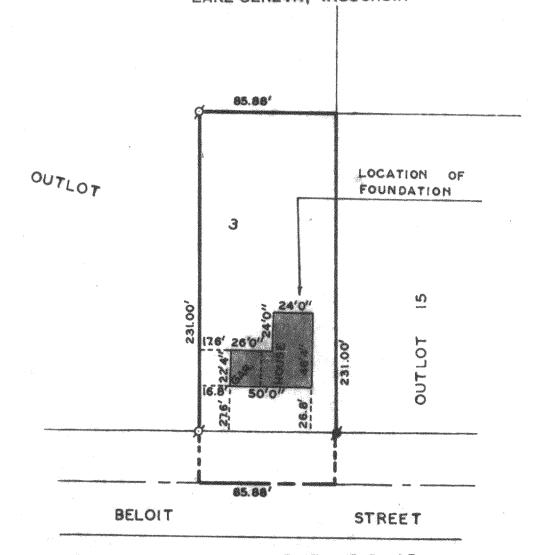

C - IRON PIPE FOUND

O - IRON PIPE PLACED

• - CONCRETE MONUMENT

F- FOUND IRON ROD

SCALE: ["= 60"

PLAT OF SURVEY OF Part of Outlot 3 of the Assessor's Plat of the Village of Walworth, Walworth County, Wis., showing the location of the foundation of a house.

> I. HAROLD H. KOLB, DO HEREBY CERTIFY THAT I HAVE SURVEYED THE PROPERTY HEREON DESCRIBED ACCORDING TO THE OFFICIAL RECORDS, AND THAT THE PLAT HEREON IS A CORRECT REPRESENTATION OF THE LOT LINES, and the principle lines of the buildings thereon.

WISCONSIN REGISTERED LAND SURVEYOR, S-187

DATE July 28, 1965

VWP-JA