

**REGISTERED PROFESSIONAL LAND SURVEYOR  
LAKE GENEVA, WISCONSIN**

**KENOSHA STREET**  
**66' WIDE**  
**COUNTY TRUNK HIGHWAY "B"**

176.76' (176.38')  
 176.30' (176.00')

300.00'  
 267.00'

33.00'  
 33.00'

88°56'  
 91°05'

30.0'  
 64.0'  
 30.0'  
 64.0'

BUILDING LOCATION

30.2'  
 32.3'  
 90°20'  
 64.6'  
 33.9'  
 35.1'

267.00'  
 300.00'

89°39'

172.92'

φ — IRON PIPE FOUND  
 O — IRON PIPE PLACED  
 ● — CONCRETE MONUMENT  
 x — SPIKE  
 ( ) — AS DEEDED




SCALE: 1" = 60'

**I, HAROLD H. KOLB, DO HEREBY CERTIFY THAT I HAVE SURVEYED THE PROPERTY HEREON DESCRIBED ACCORDING TO THE OFFICIAL RECORDS, AND THAT THE PLAT HEREON IS A CORRECT REPRESENTATION OF THE LOT LINES.**

Harold H. Kolt

HAROLD H. KOLB  
WISCONSIN REGISTERED LAND SURVEYOR, S-187

DATE February 17, 1972

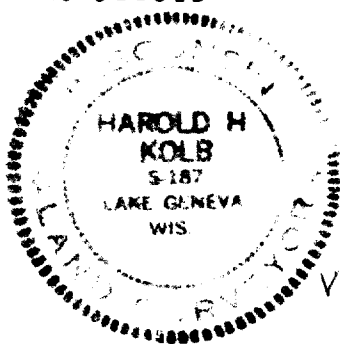

VWUP-11  
11A

~~19-85~~ 19-85/14