



FARRIS, HANSEN & ASSOCIATES, INC.
 ENGINEERING — ARCHITECTURE — SURVEYING
 7 RIDGWAY COURT — P.O. BOX 437 — ELKHORN, WISCONSIN 53121
 PHONE: (262) 723-2098 FAX: (262) 723-5886

— WORK ORDERED BY —
 RICHARD SZATKO
 10701 KNICKERBOCKER ROAD
 HARVARD, IL 60033

PLAT OF SURVEY

LOT 11 OF INDIAN PRAIRIE SUBDIVISION
 LOCATED IN THE NW 1/4 OF SECTION 27,
 TOWN 1 NORTH, RANGE 16 EAST,
 WALWORTH COUNTY, WISCONSIN

GRID NORTH
 WISCONSIN STATE PLANE COORDINATE SYSTEM — SOUTH ZONE
 WEST LINE OF THE NW 1/4 OF SECTION 27-1-16
 BEARS N 01°42'46" W
 NAD 1927

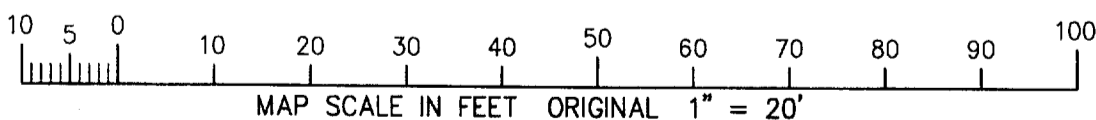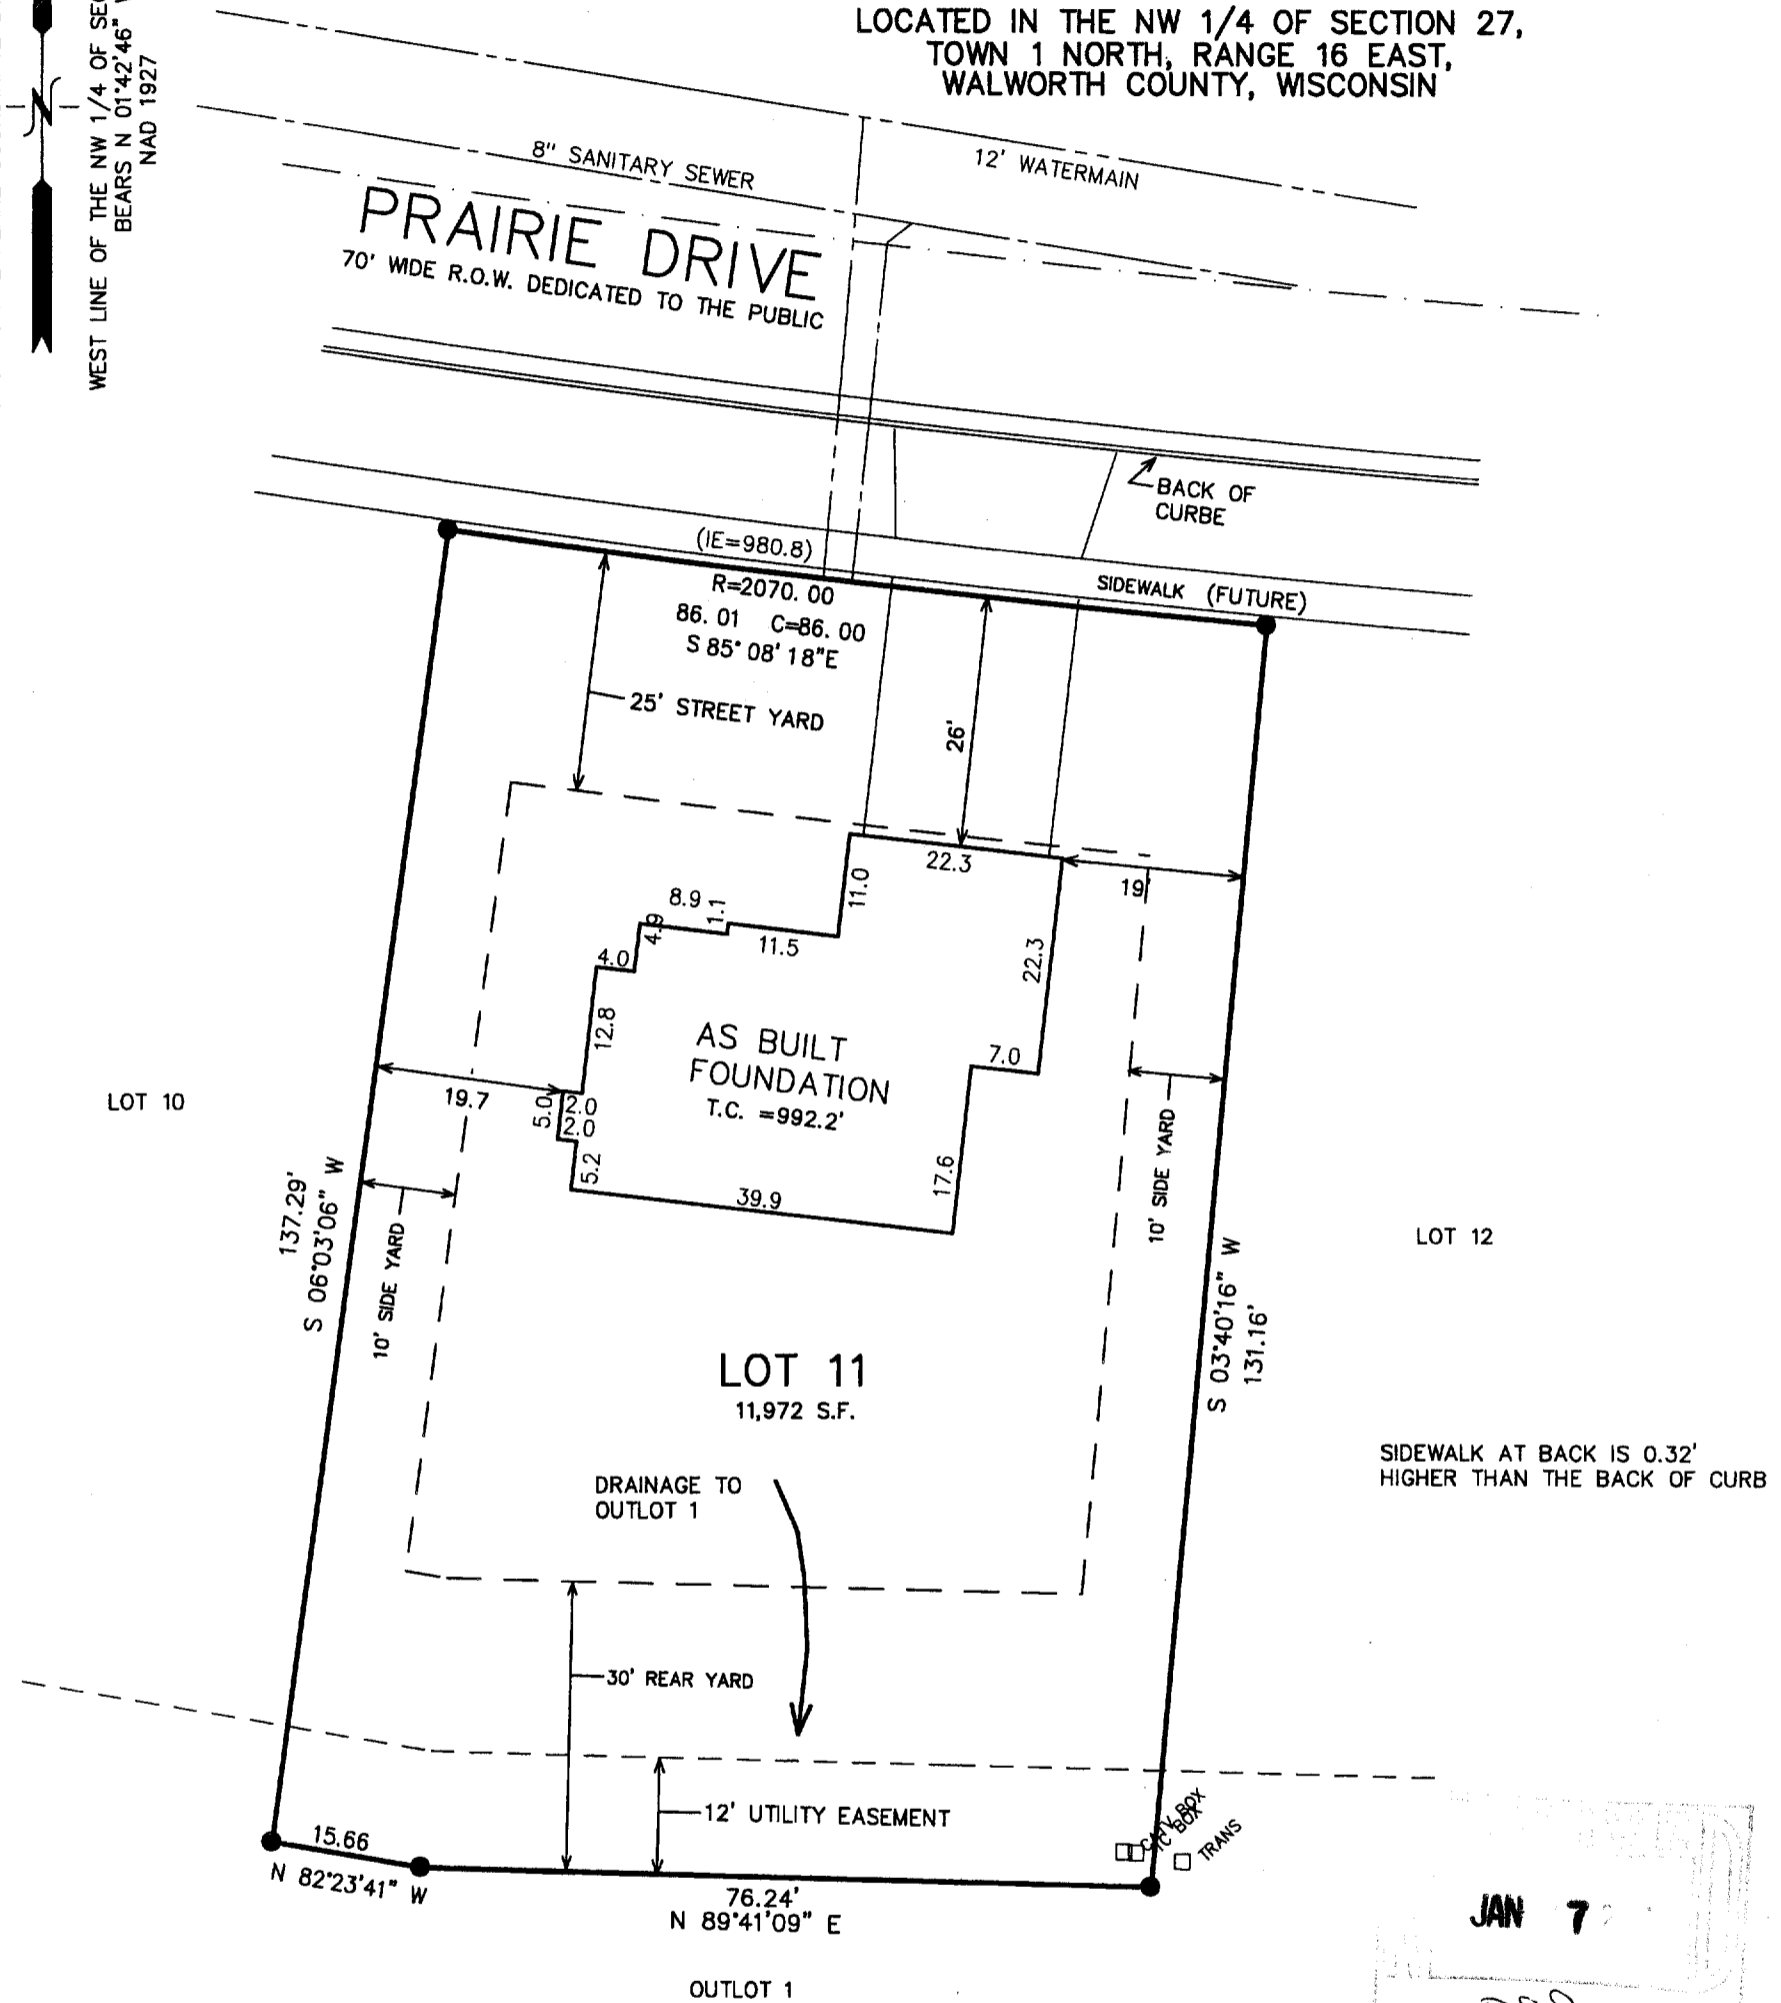

NOTE: COPIES OF THIS MAP TO WHICH THE FOLLOWING CERTIFICATE WILL APPLY SHOW THE SURVEYOR'S ORIGINAL SEAL AND SIGNATURE IN RED INK. COPIES BY ANY OTHER MEANS MAY HAVE ALTERATIONS WHICH DO NOT REPRESENT THE SURVEYOR'S WORK PRODUCT.

I HEREBY CERTIFY THAT THE ABOVE DESCRIBED PROPERTY HAS BEEN SURVEYED UNDER MY DIRECTION AND THAT THE ABOVE MAP IS A TRUE REPRESENTATION THEREOF AND SHOWS THE SIZE AND LOCATION OF THE PROPERTY AND ITS EXTERIOR BOUNDARIES. THIS SURVEY IS MADE FOR THE USE OF THE PRESENT OWNERS OF THE PROPERTY, AND ALSO THOSE WHO PURCHASE, MORTGAGE, OR GUARANTEE THE TITLE THERETO WITHIN ONE YEAR FROM THE DATE HEREOF.

DATED: SEPTEMBER 25, 2003

REVISED 11-07-2003
 TO SHOW SIZE & LOCATION OF
 AS BUILT FOUNDATION

PETER S. GORDON R.L.S. 2101

- LEGEND**
- = SET IRON REBAR STAKE, 3/4"x 24"x1.50 lbs./ft.
 - (XXX) = RECORDED AS
 - G.E. = GARAGE ENTRY ELEVATION
 - T.C. = TOP OF FOUNDATION ELEVATION
 - XXX.X = EXISTING GROUND ELEVATION

PROJECT: 5189.11
 DATE: 09/25/2003
 SHEET 1 OF 1

VIP-11

009-879