


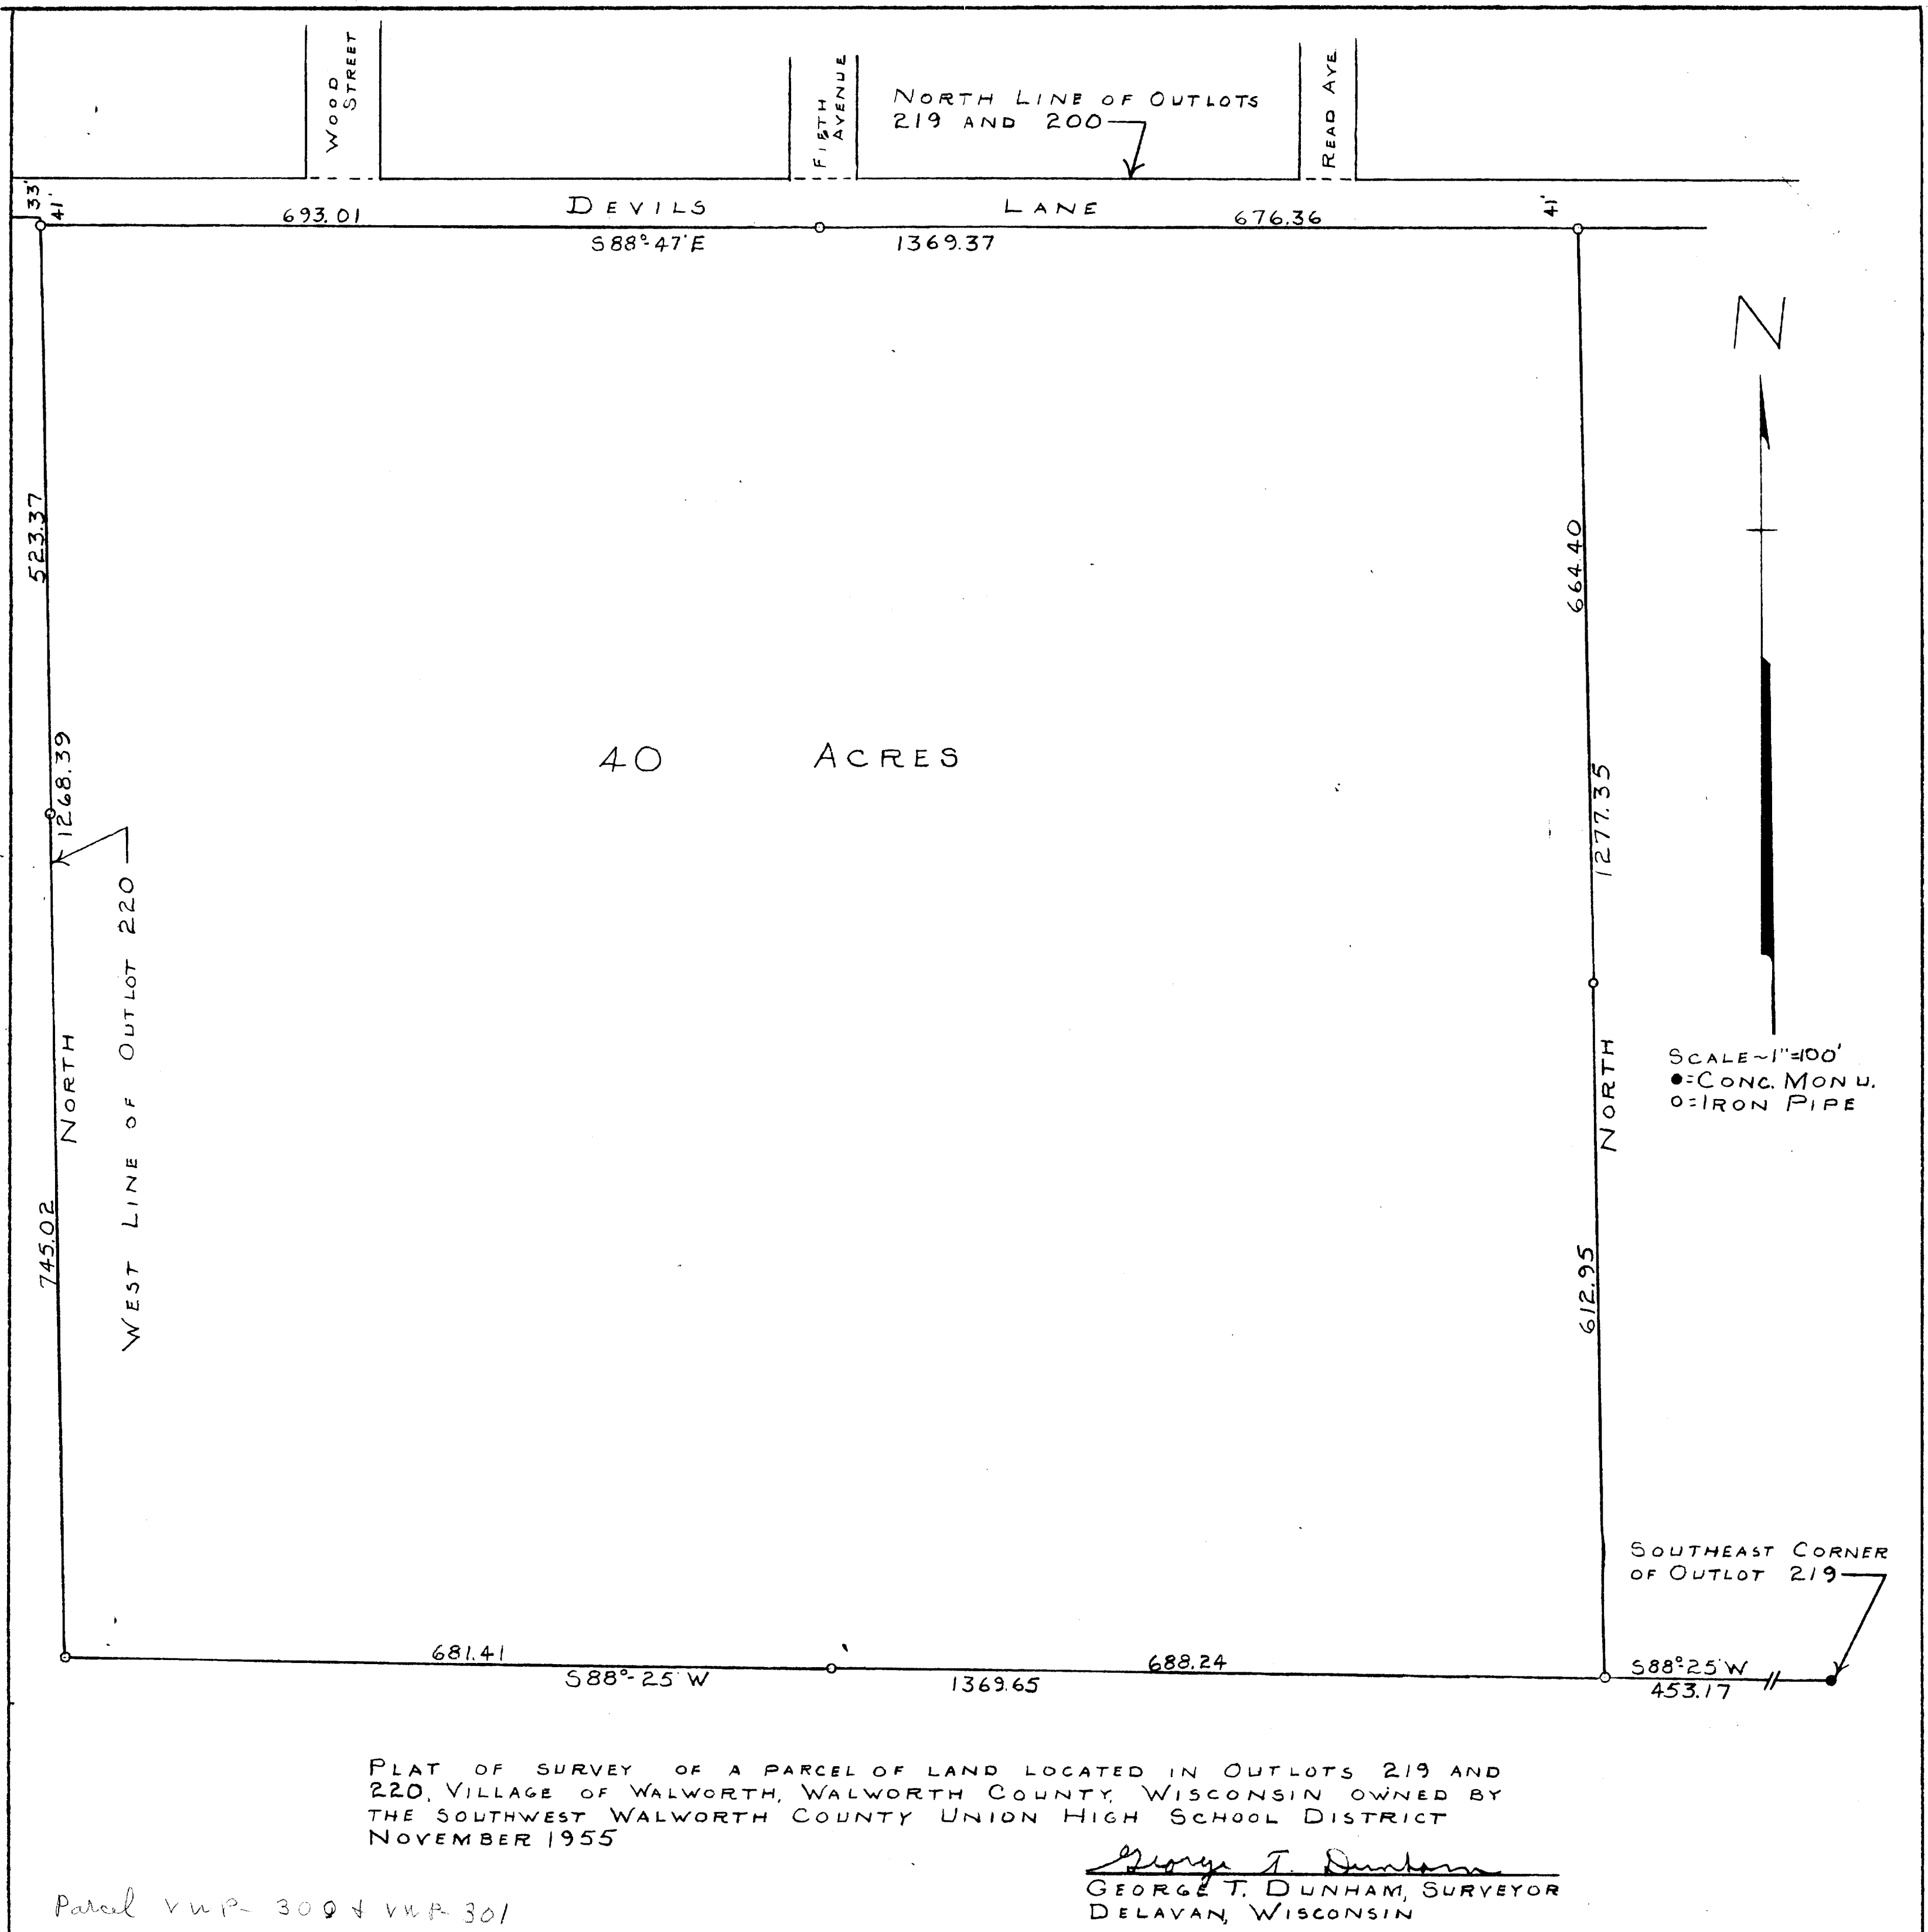

PLAT OF SURVEY OF A PARCEL OF LAND LOCATED IN OUTLOTS 219 AND 220, VILLAGE OF WALWORTH, WALWORTH COUNTY, WISCONSIN OWNED BY THE SOUTHWEST WALWORTH COUNTY UNION HIGH SCHOOL DISTRICT NOVEMBER 1955

Parcel VWP 300 + VWP 301

George T. Dunham
GEORGE T. DUNHAM, SURVEYOR
DEHAVAN, WISCONSIN