


PREPARED FOR : RE/MAX GENEVA REALTY, LTD
C/O JOHN LAW
101 BROAD ST. SUITE 102
LAKE GENEVA WI. 53147

PLAT OF SURVEY

J.K. SURVEYING INC.
N3705 WILLOWBEND LANE
LAKE GENEVA, WI, 53147
262-248-3697

- OF -

COMMENCING AT THE 1/4 SECTION LINE 1309.5 FEET WEST OF THE 1/4 CORNER OF THE EAST SIDE OF SECTION 21, TOWN 1 NORTH, RANGE 16 EAST; THENCE NORTH 14 RODS; THENCE WEST 4 RODS 4 1/2 FEET; THENCE SOUTH 14 RODS; THENCE EAST 4 RODS 4 1/2 FEET TO THE PLACE OF BEGINNING, BEING IN THE VILLAGE OF WALWORTH, WALWORTH COUNTY, WISCONSIN; ALSO KNOWN AS OUTLOT 15, ASSESSORS PLAT, VILLAGE OF WALWORTH.

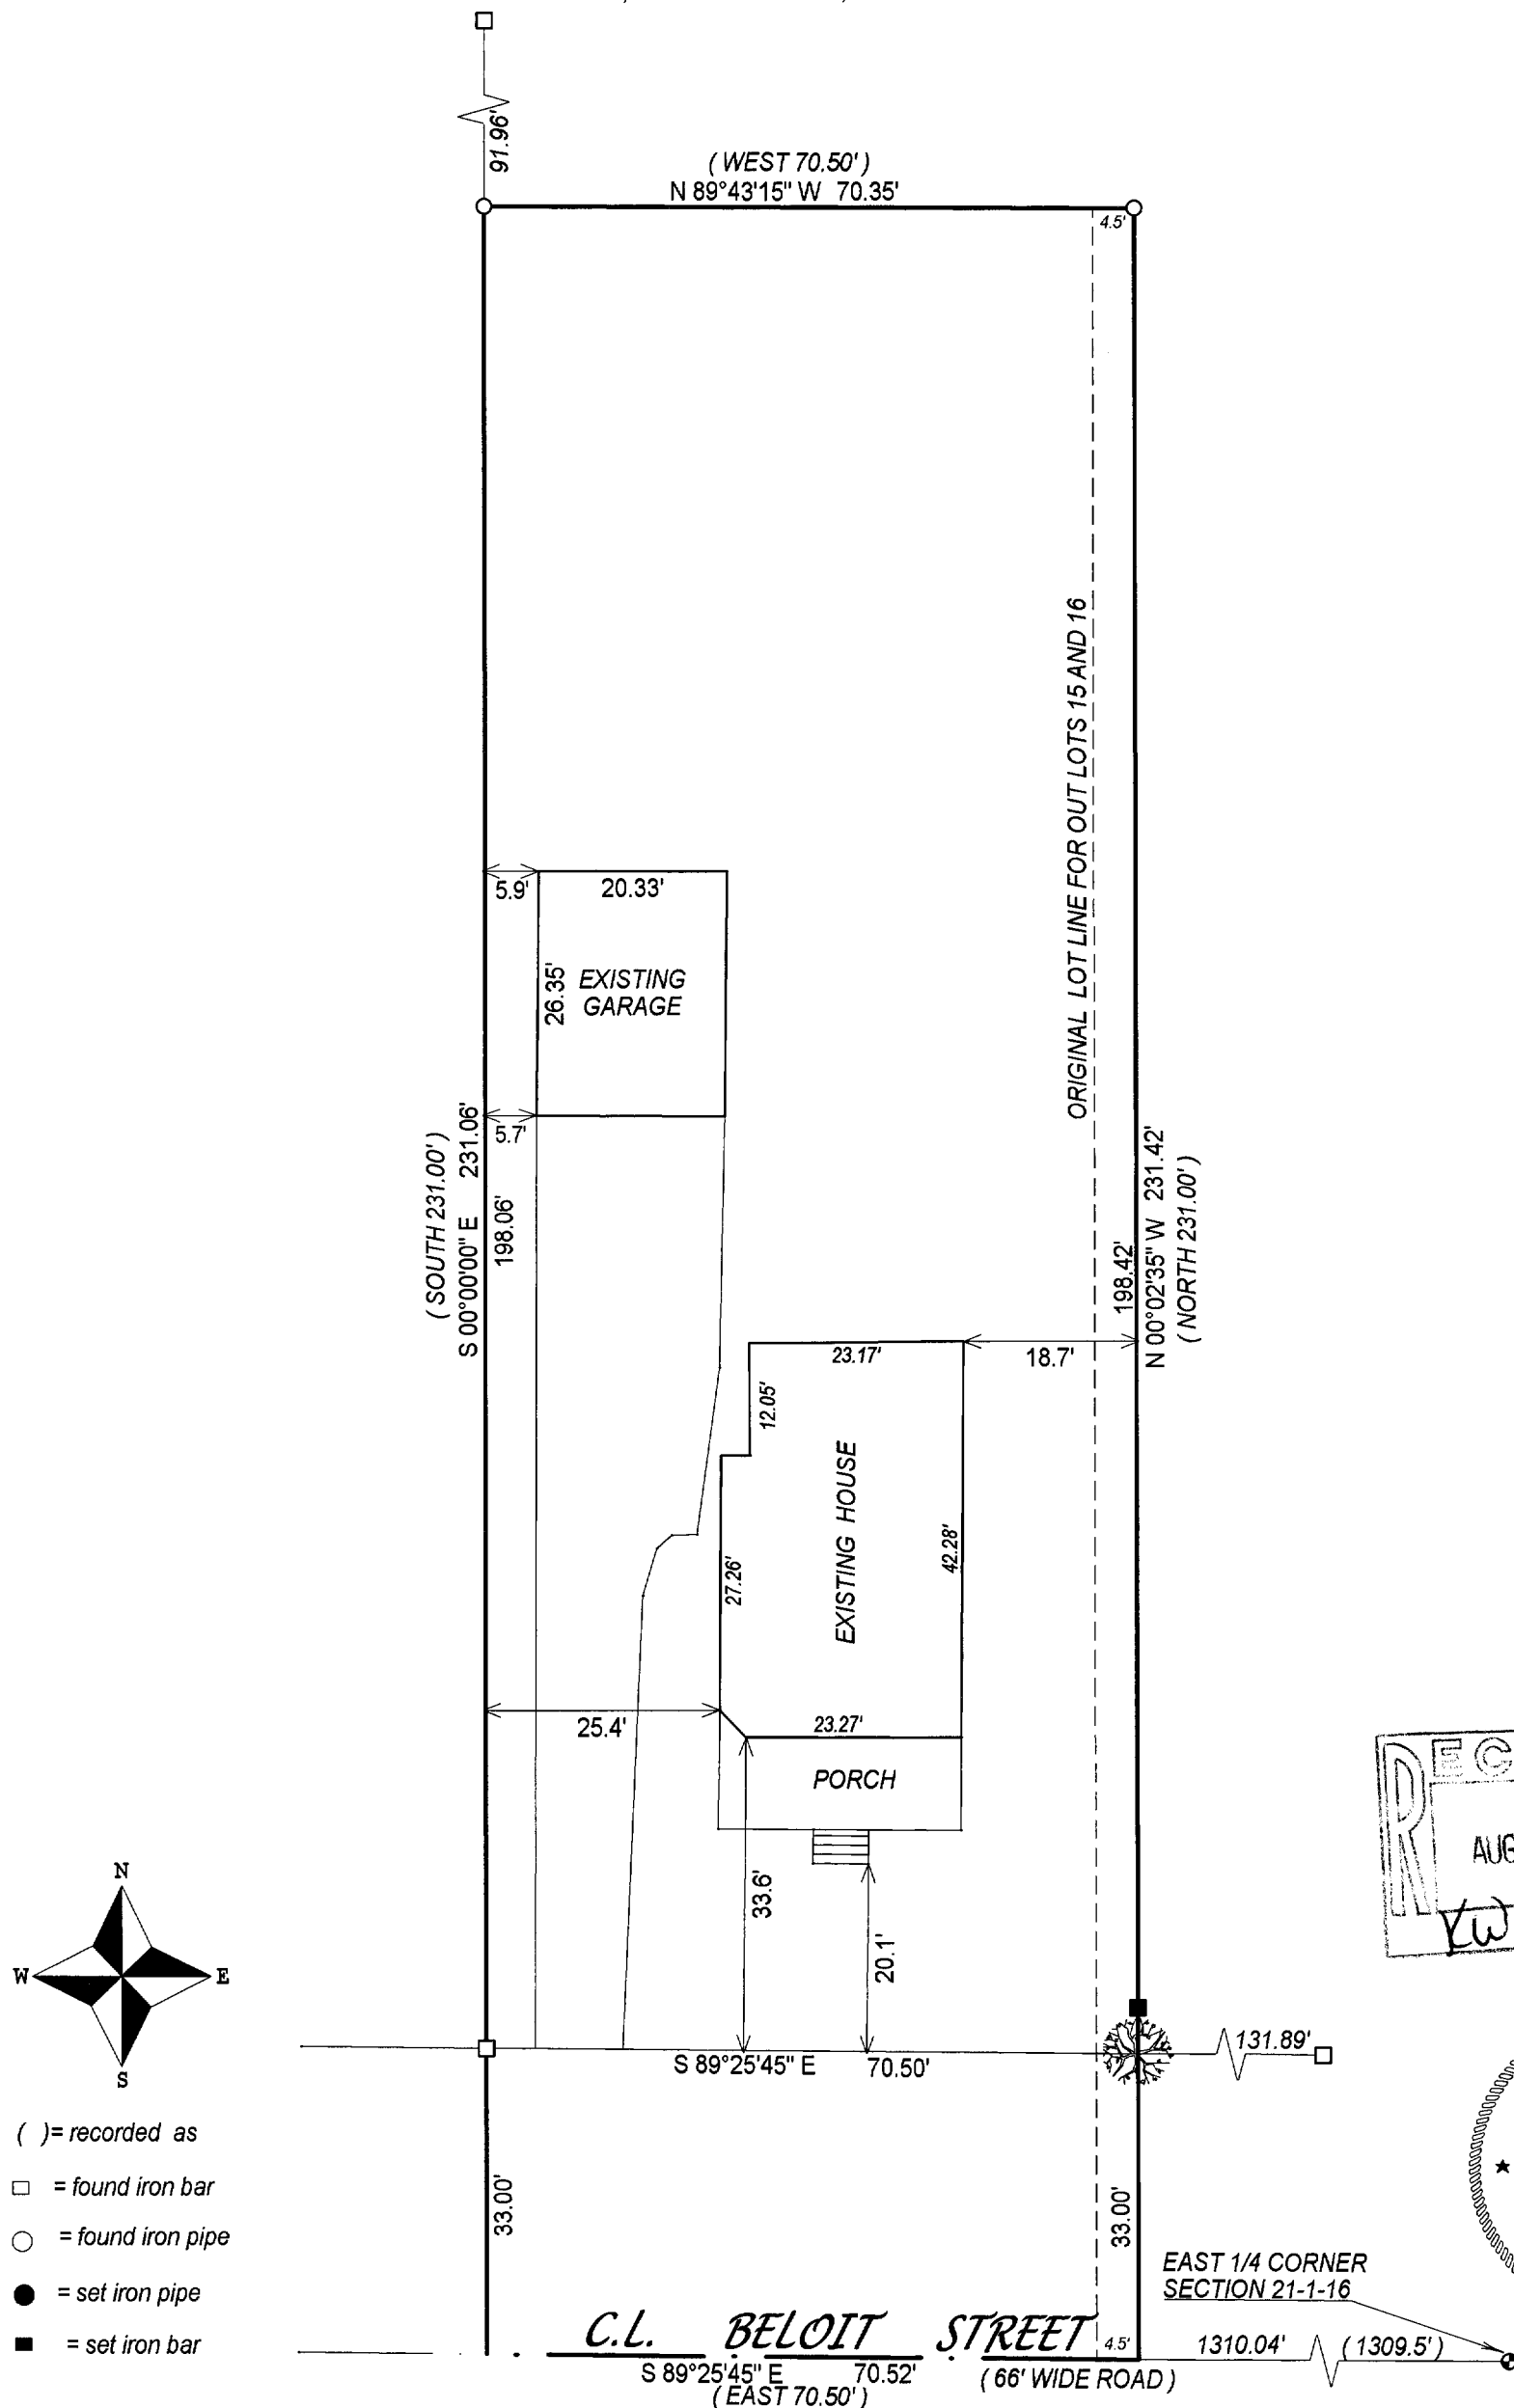

- () = recorded as
□ = found iron bar
○ = found iron pipe
● = set iron pipe
■ = set iron bar

SCALE 1" = 20'



JOB # 04-276

TAX ID # VWP00024

COMPARE LEGAL DESCRIPTION ABOVE AND DRAWING WITH DEED. FOR BUILDING RESTRICTIONS AND EASEMENTS NOT SHOWN, REFER TO DEED, ABSTRACT SOURCES AND LOCAL MUNICIPAL CODES. NOTIFY THE SURVEYOR IMMEDIATELY OF ANY DISCREPANCY.

"I hereby certify that I have surveyed the above described property and that the above map, to the best of my knowledge and belief, is a true representation thereof and shows the size and location of all visible structures, apparent easements and encroachments if any."

This survey is made for the present owners of the property, and those who purchase, mortgage, or guarantee the title thereto, within one year from the date hereof.

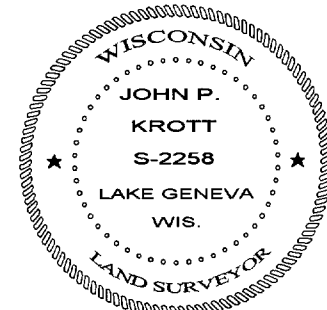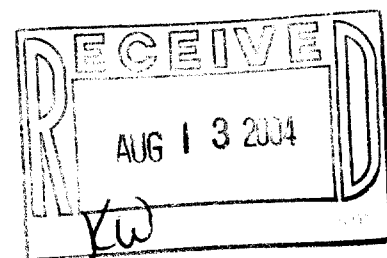

John P. Krott
JOHN KROTT S - 2258
Wisconsin Registered Land Surveyor
(original if signed in red)

DATED THIS THE 3rd DAY OF JUNE 2004.

009-919