


# ABELL SURVEYING & MAPPING

1140 SEQUOIA STREET • DELAVAN, WISCONSIN 53115  
262-728-6737

DEVILS

LANE

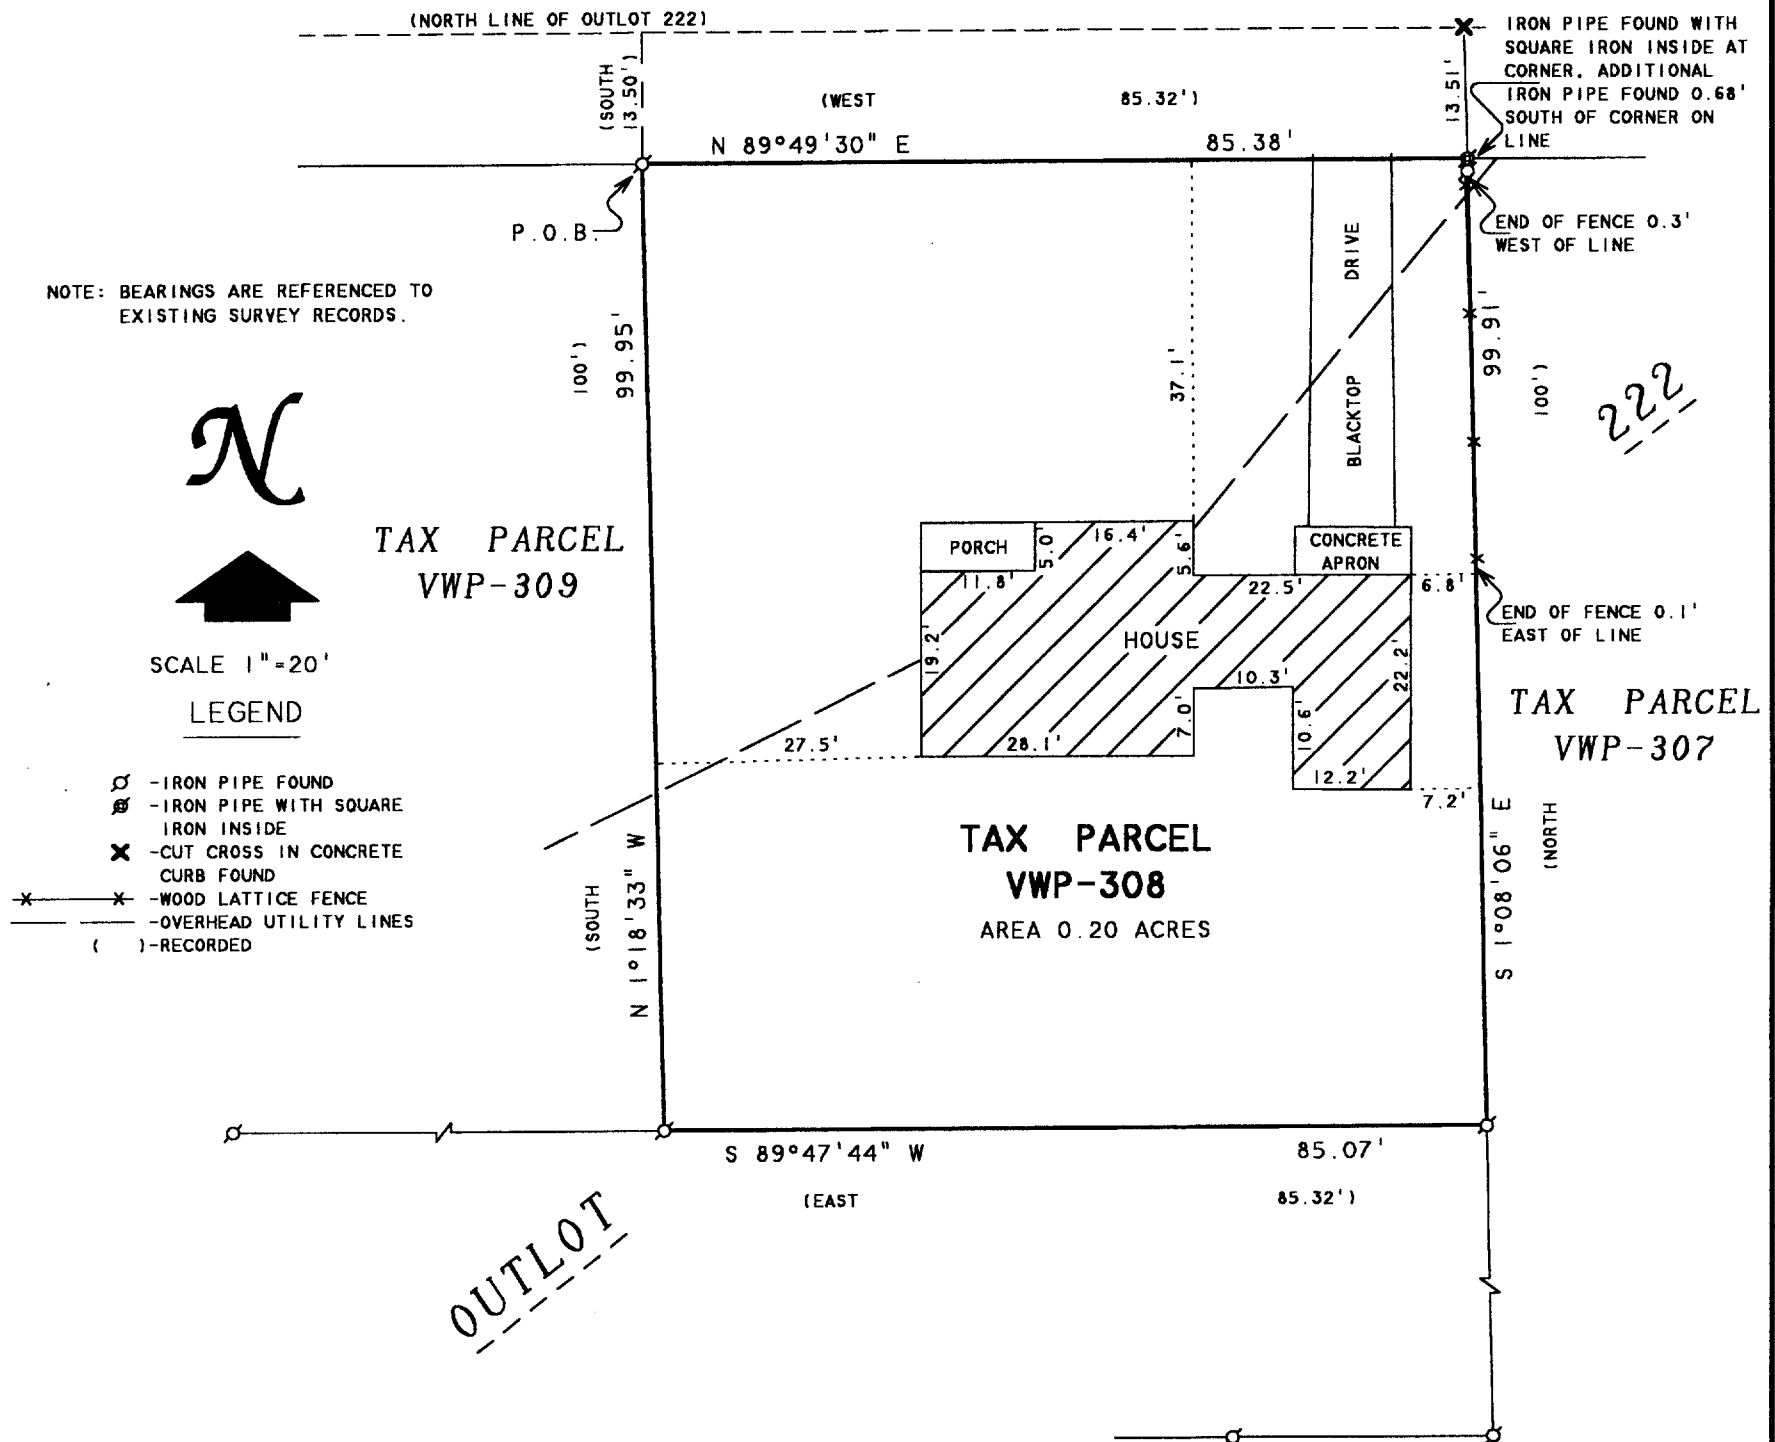

## PLAT OF SURVEY OF

COMMENCING AT THE NORTHWEST CORNER OF OUTLOT 222, ASSESSOR'S PLAT IN THE VILLAGE OF WALWORTH, WALWORTH COUNTY, WISCONSIN: THENCE EAST 174.68 FEET ALONG THE NORTH LINE OF SAID OUTLOT 222; THENCE SOUTH 13.50 FEET PARALLEL TO THE WEST LINE OF SAID OUTLOT 222 TO THE PLACE OF BEGINNING; THENCE CONTINUE SOUTH 100 FEET; THENCE EAST 85.32 FEET PARALLEL TO THE NORTH LINE OF SAID OUTLOT 222; THENCE NORTH 100 FEET PARALLEL TO THE WEST LINE OF SAID OUTLOT 222; THENCE WEST 85.32 FEET PARALLEL TO THE NORTH LINE OF SAID OUTLOT 222 TO THE PLACE OF BEGINNING.

I HEREBY CERTIFY THAT I HAVE SURVEYED THE ABOVE DESCRIBED PROPERTY AND THAT THE ABOVE MAP IS A TRUE REPRESENTATION THEREOF AND SHOWS THE SIZE AND LOCATION OF THE PROPERTY, ITS EXTERIOR BOUNDARIES, THE LOCATION OF ALL VISIBLE STRUCTURES AND DIMENSIONS OF ALL PRINCIPAL BUILDINGS THEREON, BOUNDARY FENCES, APPARENT EASEMENTS, ROADWAYS AND VISIBLE ENCROACHMENTS, IF ANY, TO THE BEST OF MY KNOWLEDGE AND BELIEF.

THIS SURVEY IS MADE FOR THE USE OF THE PRESENT OWNERS OF THE PROPERTY, AND ALSO THOSE WHO PURCHASE, MORTGAGE, OR GUARANTEE THE TITLE THERETO WITHIN ONE (1) YEAR FROM DATE HEREON.

*David F. Abell*  
DAVID F. ABELL  
WISCONSIN REGISTERED LAND SURVEYOR, S-1596

ORDERED BY: RASMUSSEN LAW OFFICE  
113 KENOSHA STREET  
WALWORTH, WI 53184

September 29, 2004

DATE: September 29, 2004 JOB NUMBER - 04119  
NOTE: THIS IS NOT A CERTIFIED COPY UNLESS SEALED.

VWP-308

009-962