


**ABELL
SURVEYING & MAPPING
DELAVER, WISCONSIN 53118
414-728-6757**

**AVENUE
READ**

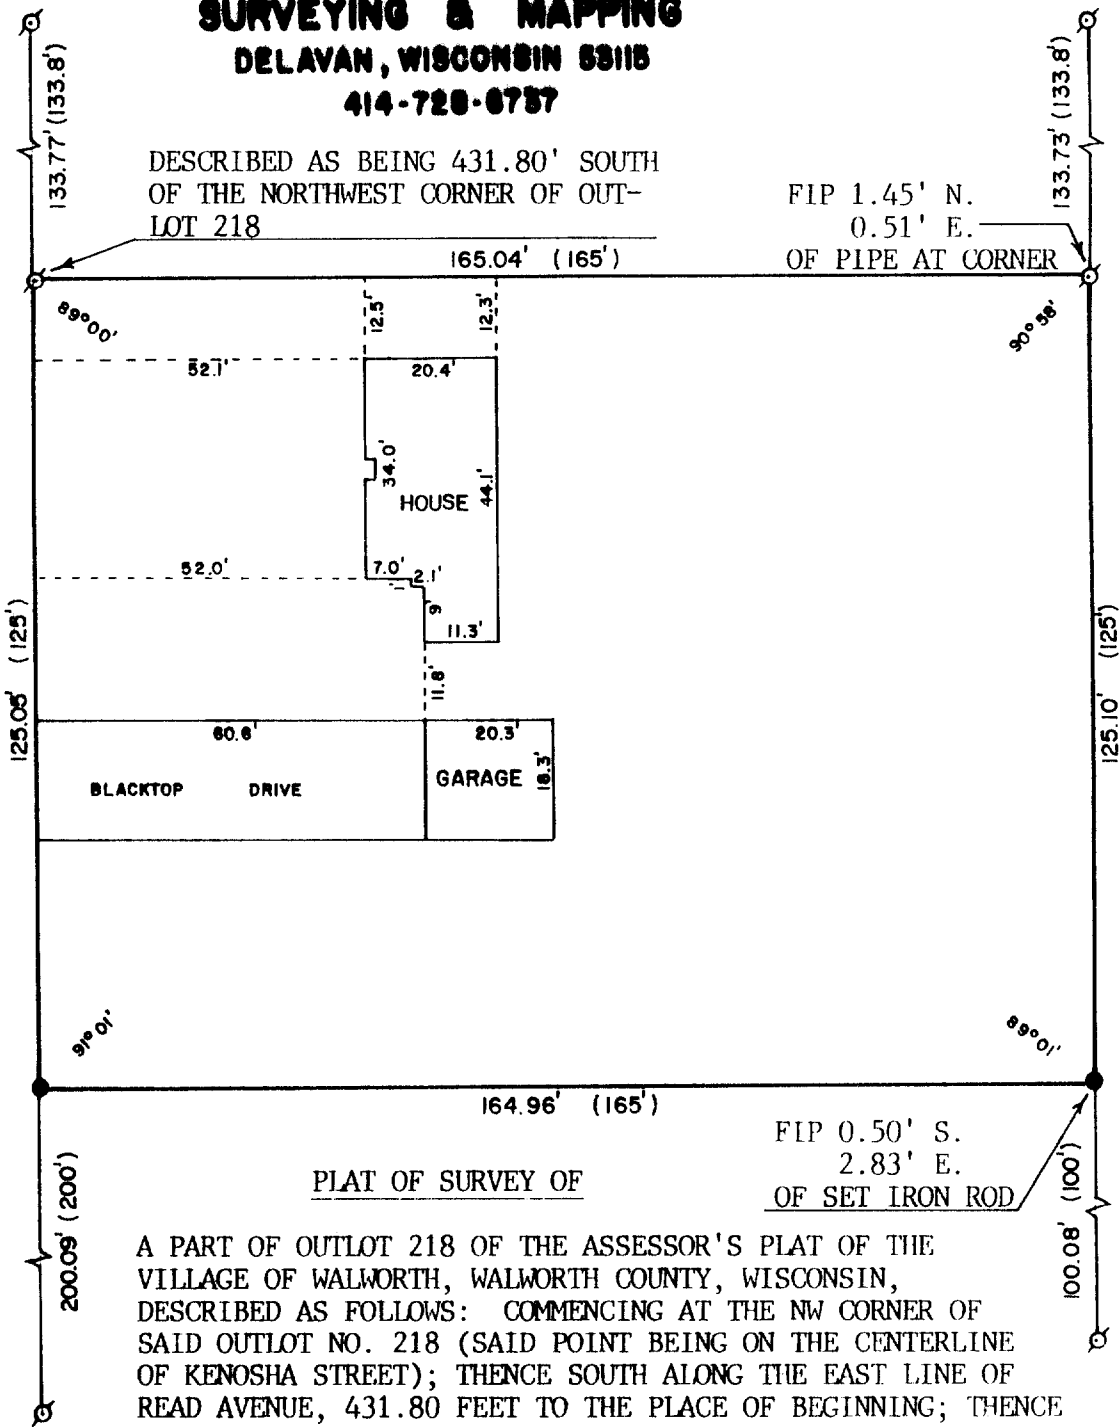


PLAT OF SURVEY OF

A PART OF OUTLOT 218 OF THE ASSESSOR'S PLAT OF THE
VILLAGE OF WALWORTH, WALWORTH COUNTY, WISCONSIN,
DESCRIBED AS FOLLOWS: COMMENCING AT THE NW CORNER OF
SAID OUTLOT NO. 218 (SAID POINT BEING ON THE CENTERLINE
OF KENOSHA STREET); THENCE SOUTH ALONG THE EAST LINE OF
READ AVENUE, 431.80 FEET TO THE PLACE OF BEGINNING; THENCE
CONTINUE SOUTH ON SAID STREET LINE 125 FEET; THENCE EAST
PARALLEL TO THE CENTERLINE OF KENOSHA STREET, 165 FEET;
THENCE NORTH PARALLEL TO THE EAST LINE OF READ AVENUE,
125 FEET; THENCE WEST 165 FEET TO THE PLACE OF BEGINNING.

FIP 0.50' S.
2.83' E.
OF SET IRON ROD

ORDERED BY: THE RAULAND AGENCY
118 KENOSHA ST.
WALWORTH, WI. 53184

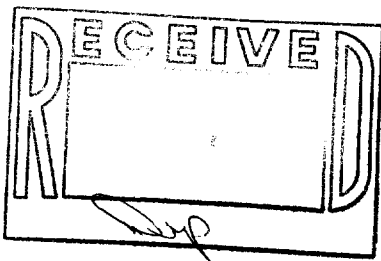

SCALE - 1"=30'

LEGEND

- ⊗ - IRON PIPE FOUND
- - 3/4" DIA. IRON ROD SET
- () - RECORDED AS

I HEREBY CERTIFY THAT I HAVE SURVEYED THE
ABOVE DESCRIBED PROPERTY AND THAT THE ABOVE
MAP IS A TRUE REPRESENTATION THEREOF AND
SHOWS THE SIZE AND LOCATION OF THE PROPERTY,
ITS EXTERIOR BOUNDARIES, THE LOCATION OF ALL
VISIBLE STRUCTURES AND DIMENSIONS OF ALL
PRINCIPAL BUILDINGS THEREON, BOUNDARY FENCES,
APPARENT EASEMENTS, ROADWAYS AND VISIBLE
ENCROACHMENTS, IF ANY, TO THE BEST OF MY
KNOWLEDGE AND BELIEF.

THIS SURVEY IS MADE FOR THE USE OF THE PRESENT
OWNERS OF THE PROPERTY, AND ALSO THOSE WHO
PURCHASE, MORTGAGE, OR GUARANTEE THE TITLE
THERETO WITHIN ONE (1) YEAR FROM DATE HEREOF.

David F. Abell
DAVID F. ABELL
WISCONSIN REGISTERED LAND SURVEYOR, S-1596

DATE *September 17, 1987* JOB NUMBER - 87135

NOTE: THIS IS NOT A CERTIFIED COPY UNLESS SEALED. 9-28