
## Plat of Survey

Survey For: Gordon J. & Jill A. Backman

Location: 531 W. Center Street, City of Whitewater, Walworth County, Wsconsin

Description: A part of Lots 1 and 2 in Block 22 of Chapman & Ludington's Addition to the City of Whitewater, located in the NE 1/4 of the SE 1/4 of Section 5, T4N, R15E, City of Whitewater, Walworth County, Wisconsin, bounded as follows: Beginning at the NW corner of said Lot 1; running thence E on the N Line of said Lots 1 and 2, 74 1/4 feet; thence S. parallel with the W line of said Lot 1, 146 feet; thence W parallel with the N line of said Lots 1 and 2, 74 1/4 feet; thence N along the W line of said Lot 1 to the point of beginning.

Subject to all rights, reservations, restrictive covenants, and easements recorded or unrecorded.

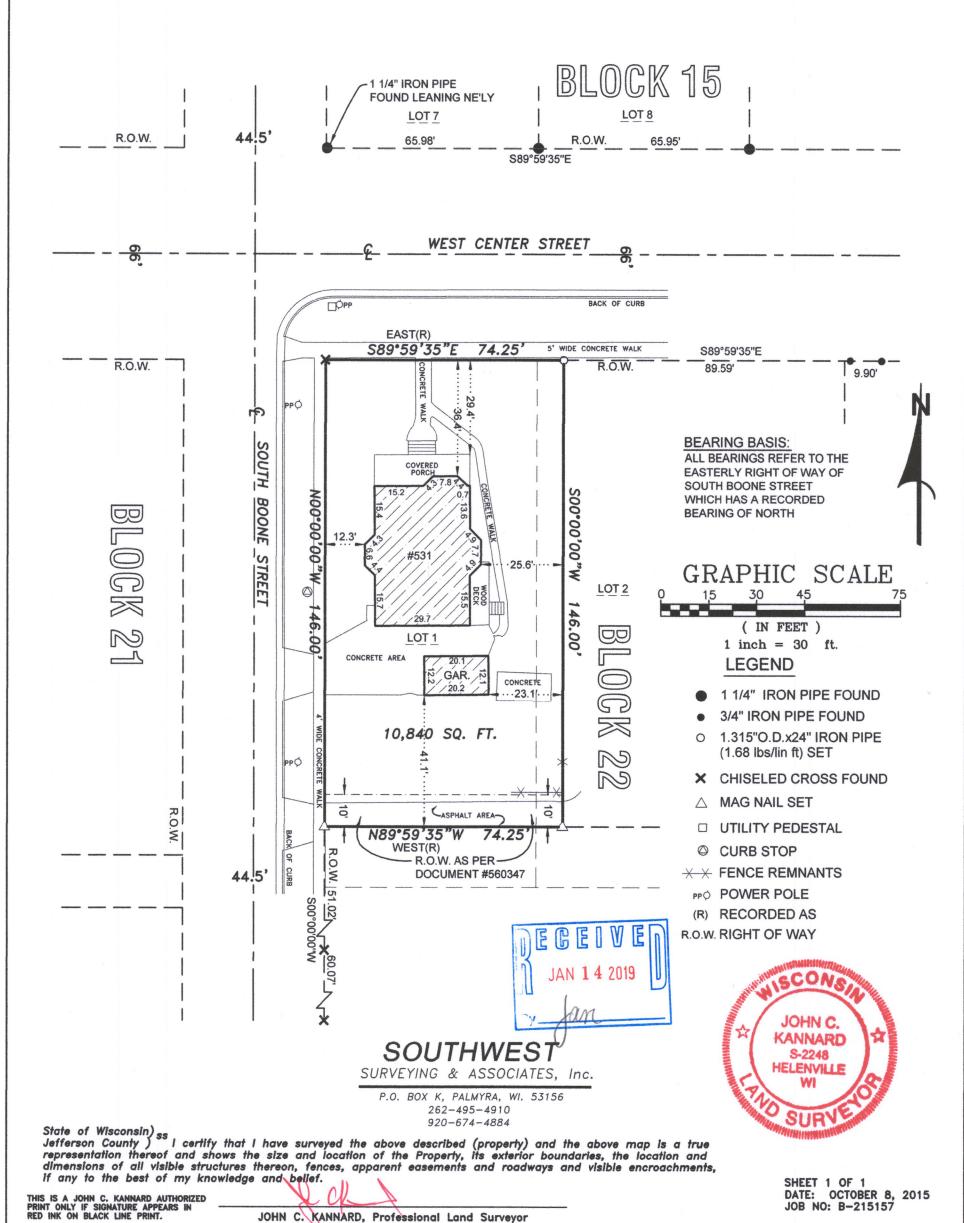

JOHN C. KANNARD, Professional Land Surveyor

1CL-40 010-1060