


# LAND-MARK SURVEYING

Mark L. Miritz

Wisconsin Professional Land Surveyor S-2582

N9330 Knuteson Drive  
Whitewater, WI 53190  
Phone: (262) 495-3284  
FAX: (262) 495-8421  
LAND-MARKSURVEYING.COM

## PLAT OF SURVEY

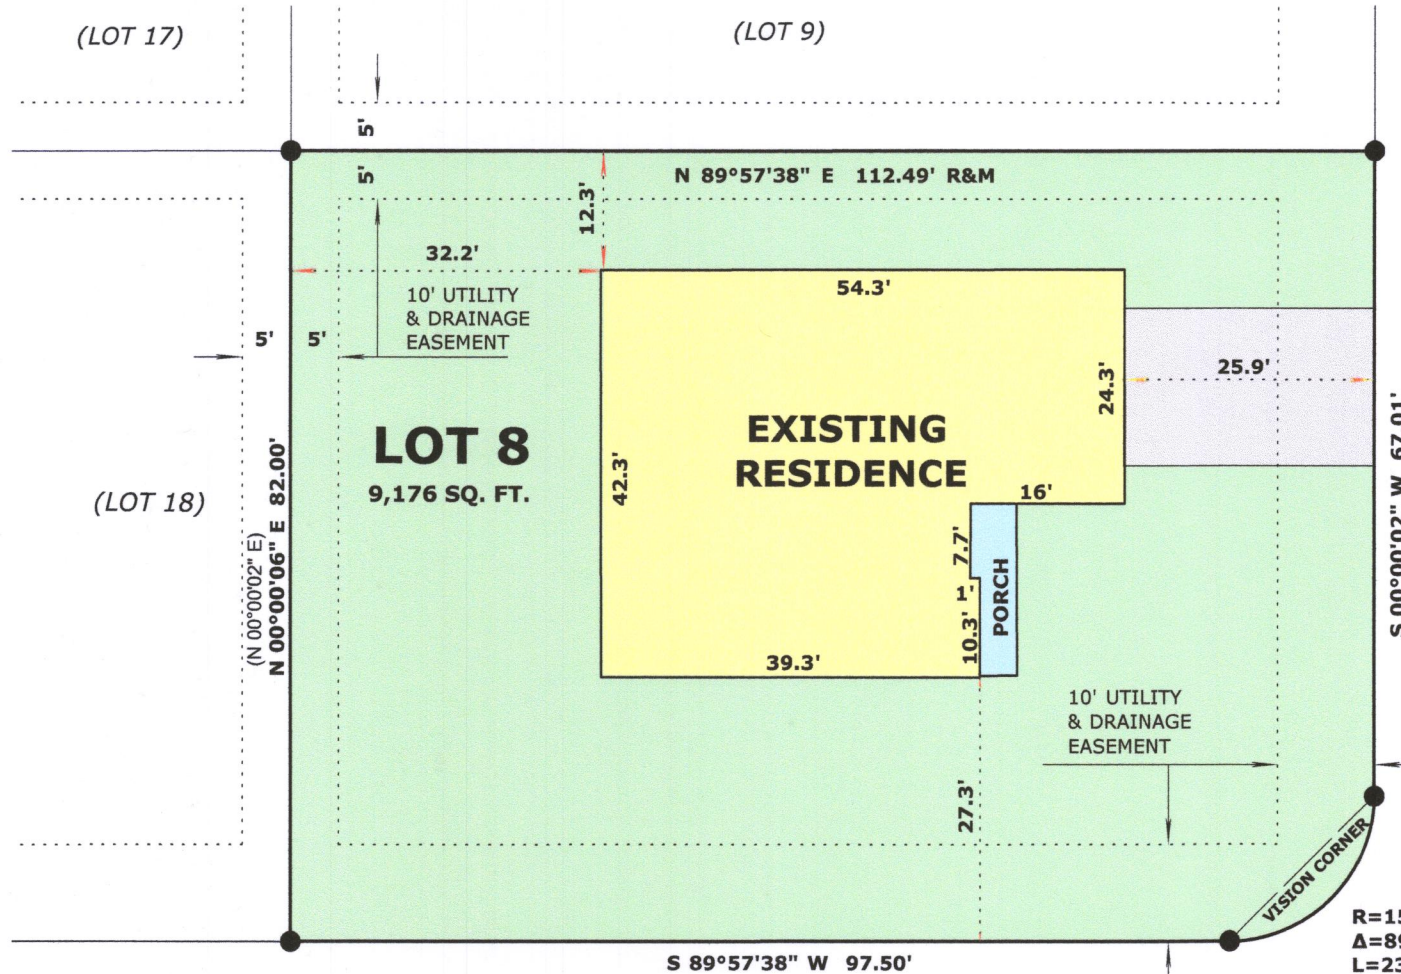


### LEGAL DESCRIPTION

LOT 8, WALTON'S PINE BLUFF SUBDIVISION,  
LOCATED IN THE SOUTHEAST 1/4, OF THE  
SOUTHEAST 1/4, SECTION 3, TOWNSHIP 4 NORTH,  
RANGE 15 EAST, IN THE CITY OF WHITEWATER,  
WALWORTH COUNTY, WISCONSIN

OWNER:  
BASSO BUILDERS INC.  
405 SKYLINE DR.  
LAKE GENEVA, WI. 53147

MAPLE LANE  
(60' WIDE)

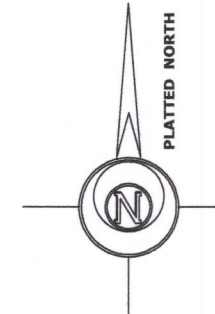

### LEGEND

- SET IRON ROD, 24" LONG, WEIGHING 1.5 LBS./LINEAL FT., 3/4" DIA.
- ( x x ) RECORDED AS DIMENSION
- x — x — EXISTING FENCE

SCALE: 1 INCH = 20 FEET

"I hereby certify that the above described property has been surveyed by me or under my direction and that the above map is a true representation thereof and shows the size and location of the property, its exterior boundaries, the location of all visible structures and dimensions of all principal buildings thereon, boundary fences, apparent easements, roadways and visible encroachments, if any."  
"This survey is made for the use of the present owners of the property, and also those who purchase, mortgage, or guarantee the title thereto within one year from date hereof."



R=15.00'  
Δ=89°57'36"  
L=23.55'  
Ch=S 44°58'50" W 21.21'

JAKE'S WAY

(66' WIDE)

REVISED APRIL 2, 2019  
TO SHOW RESIDENCE  
AS BUILT

Mark L. Miritz  
MARK L. MIRITZ  
WISCONSIN PROFESSIONAL  
LAND SURVEYOR S-2582

DATE: NOV. 28, 2018 JOB NO. 18.1107

WPB-8 010-1064