



GEORGE T. DUNHAM
SURVEYING & SUBDIVIDING
DELAVER, WISCONSIN

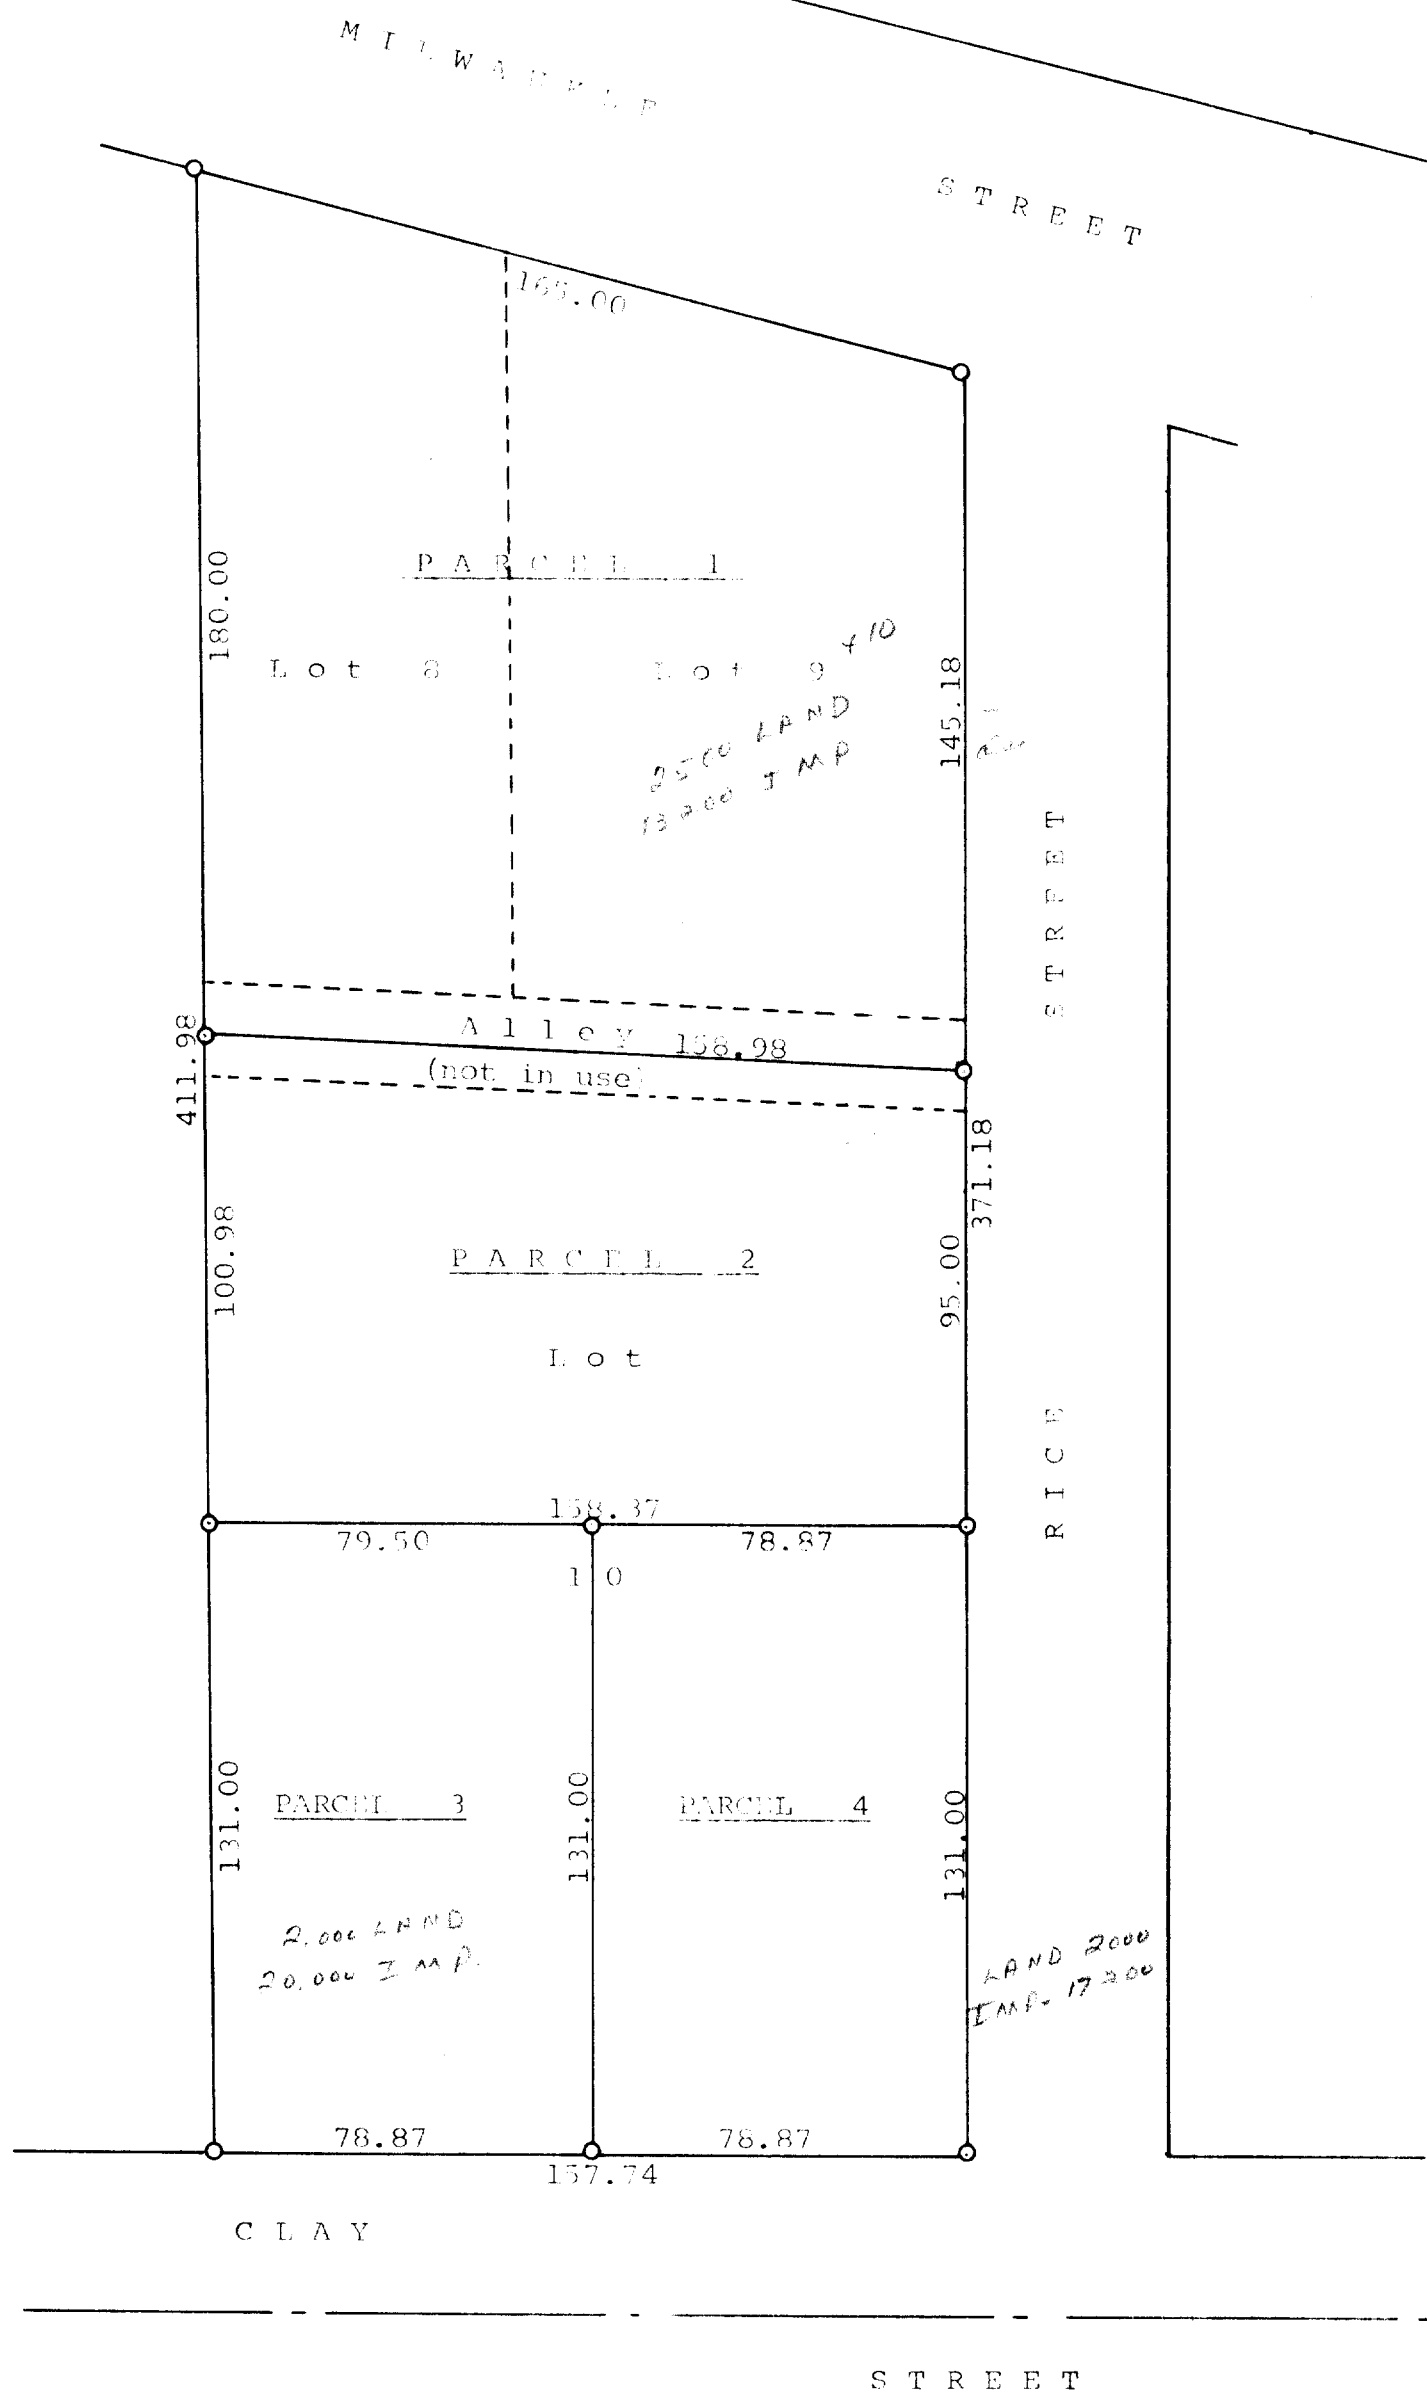

Scale - 1" = 40'
○ = Iron Pipe


Plat of survey of Lots 8, 9, & 10, Block 8 of
S. C. Hall's Addition, City of Whitewater, Walworth
County, Wisconsin.
October 11, 1968

George T. Dunham
George T. Dunham, Surveyor

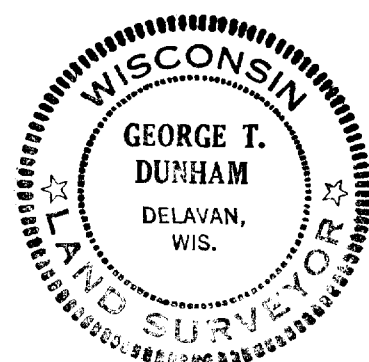

HA5-47 47A, 48, 48A, 48B

GEORGE T. DUNHAM
SURVEYING & SUBDIVIDING
DELAVER, WISCONSIN

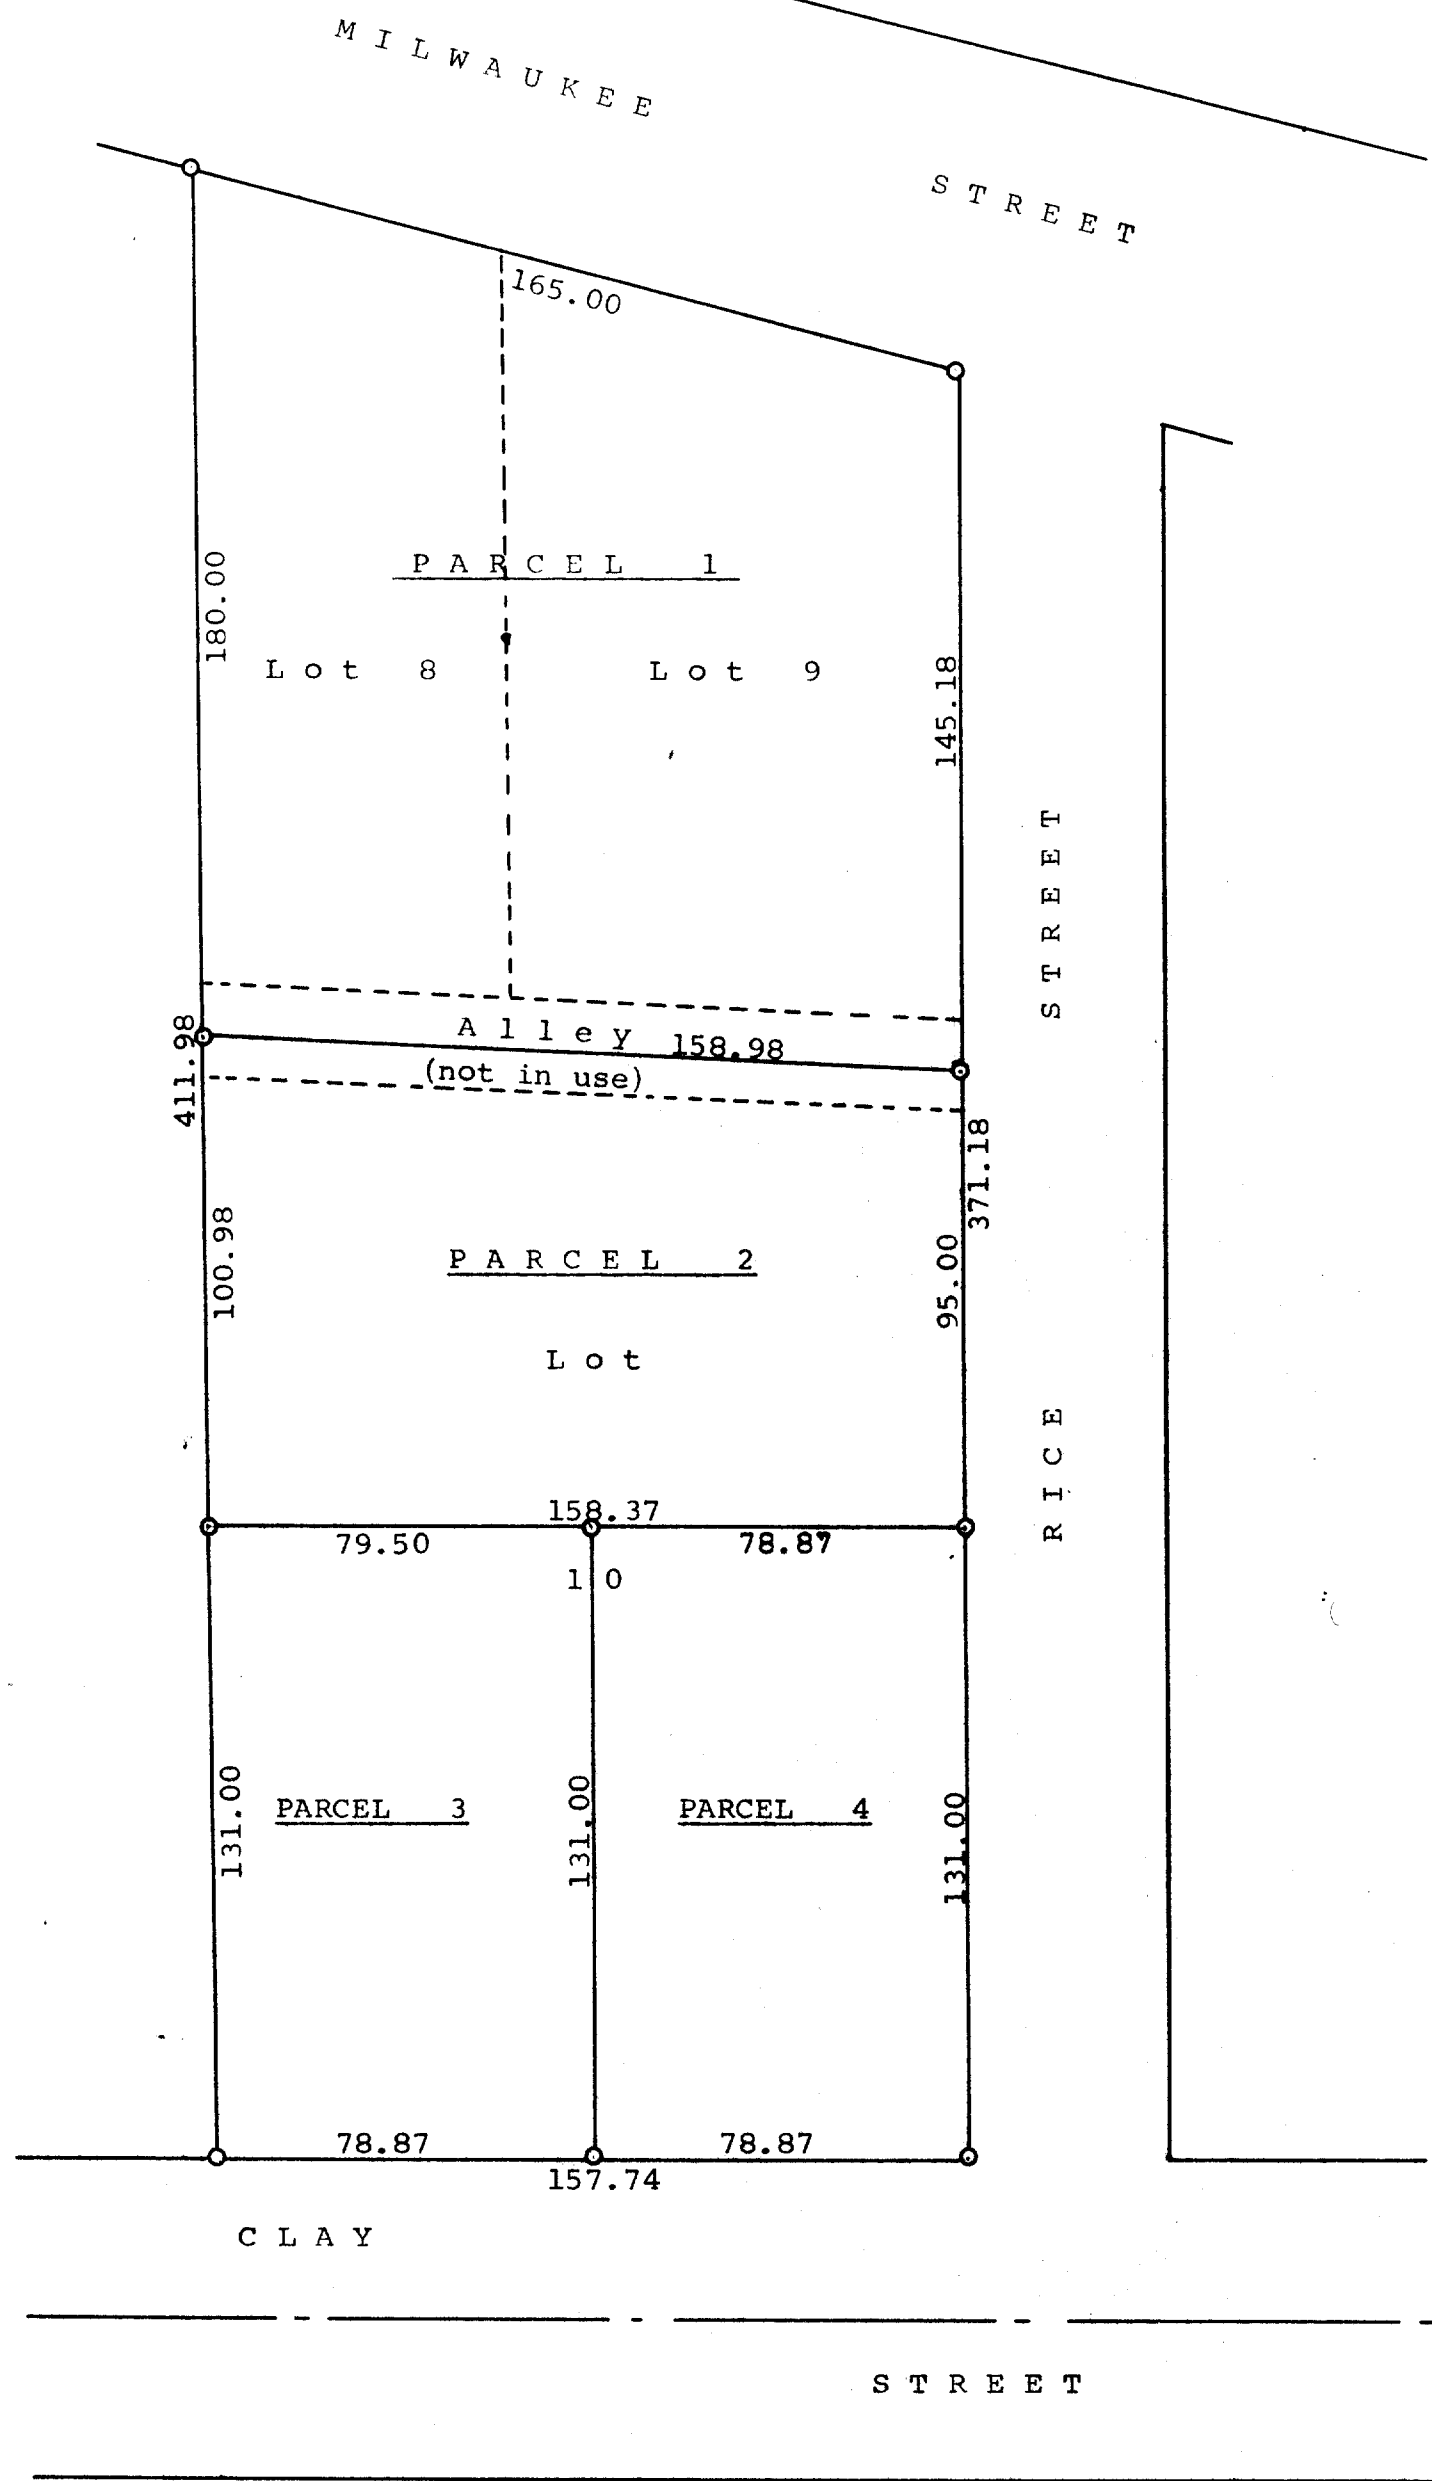

N

Scale - 1" = 40'
O = Iron Pipe

Plat of survey of Lots 8, 9, & 10, Block 8 of
S. C. Hall's Addition, City of Whitewater, Walworth
County, Wisconsin.
October 11, 1968

George T. Dunham
George T. Dunham, Surveyor

44547, 47A, 48, 48A, 48B