


**N9330 Knuteson Drive
Whitewater, WI 53190
Phone: (262) 949-1239
MARKMIRITZ@
LAND-MARKSURVEYING.COM**

Lots 1 and 2, Block 2, Corydon Pratt's Addition, City of Whitewater, Walworth County, Wisconsin, together with all that portion of the East 1/2 Queen Street abutting the aforesaid Lot 1, Block 2, and as lies Southerly of the North line of said Lot 1 extended to the centerline of said Queen Street, and as lies Northerly of the South line of said Lot 1 extended to the centerline of said Queen Street, as vacated by a Resolution recorded June 16, 1992 in Volume 575 of Records on page 131 as Document No. 285847, and as modified by an Amended Resolution recorded October 4, 1995 in Volume 637 of Records on page 1696 as Document No. 314769.

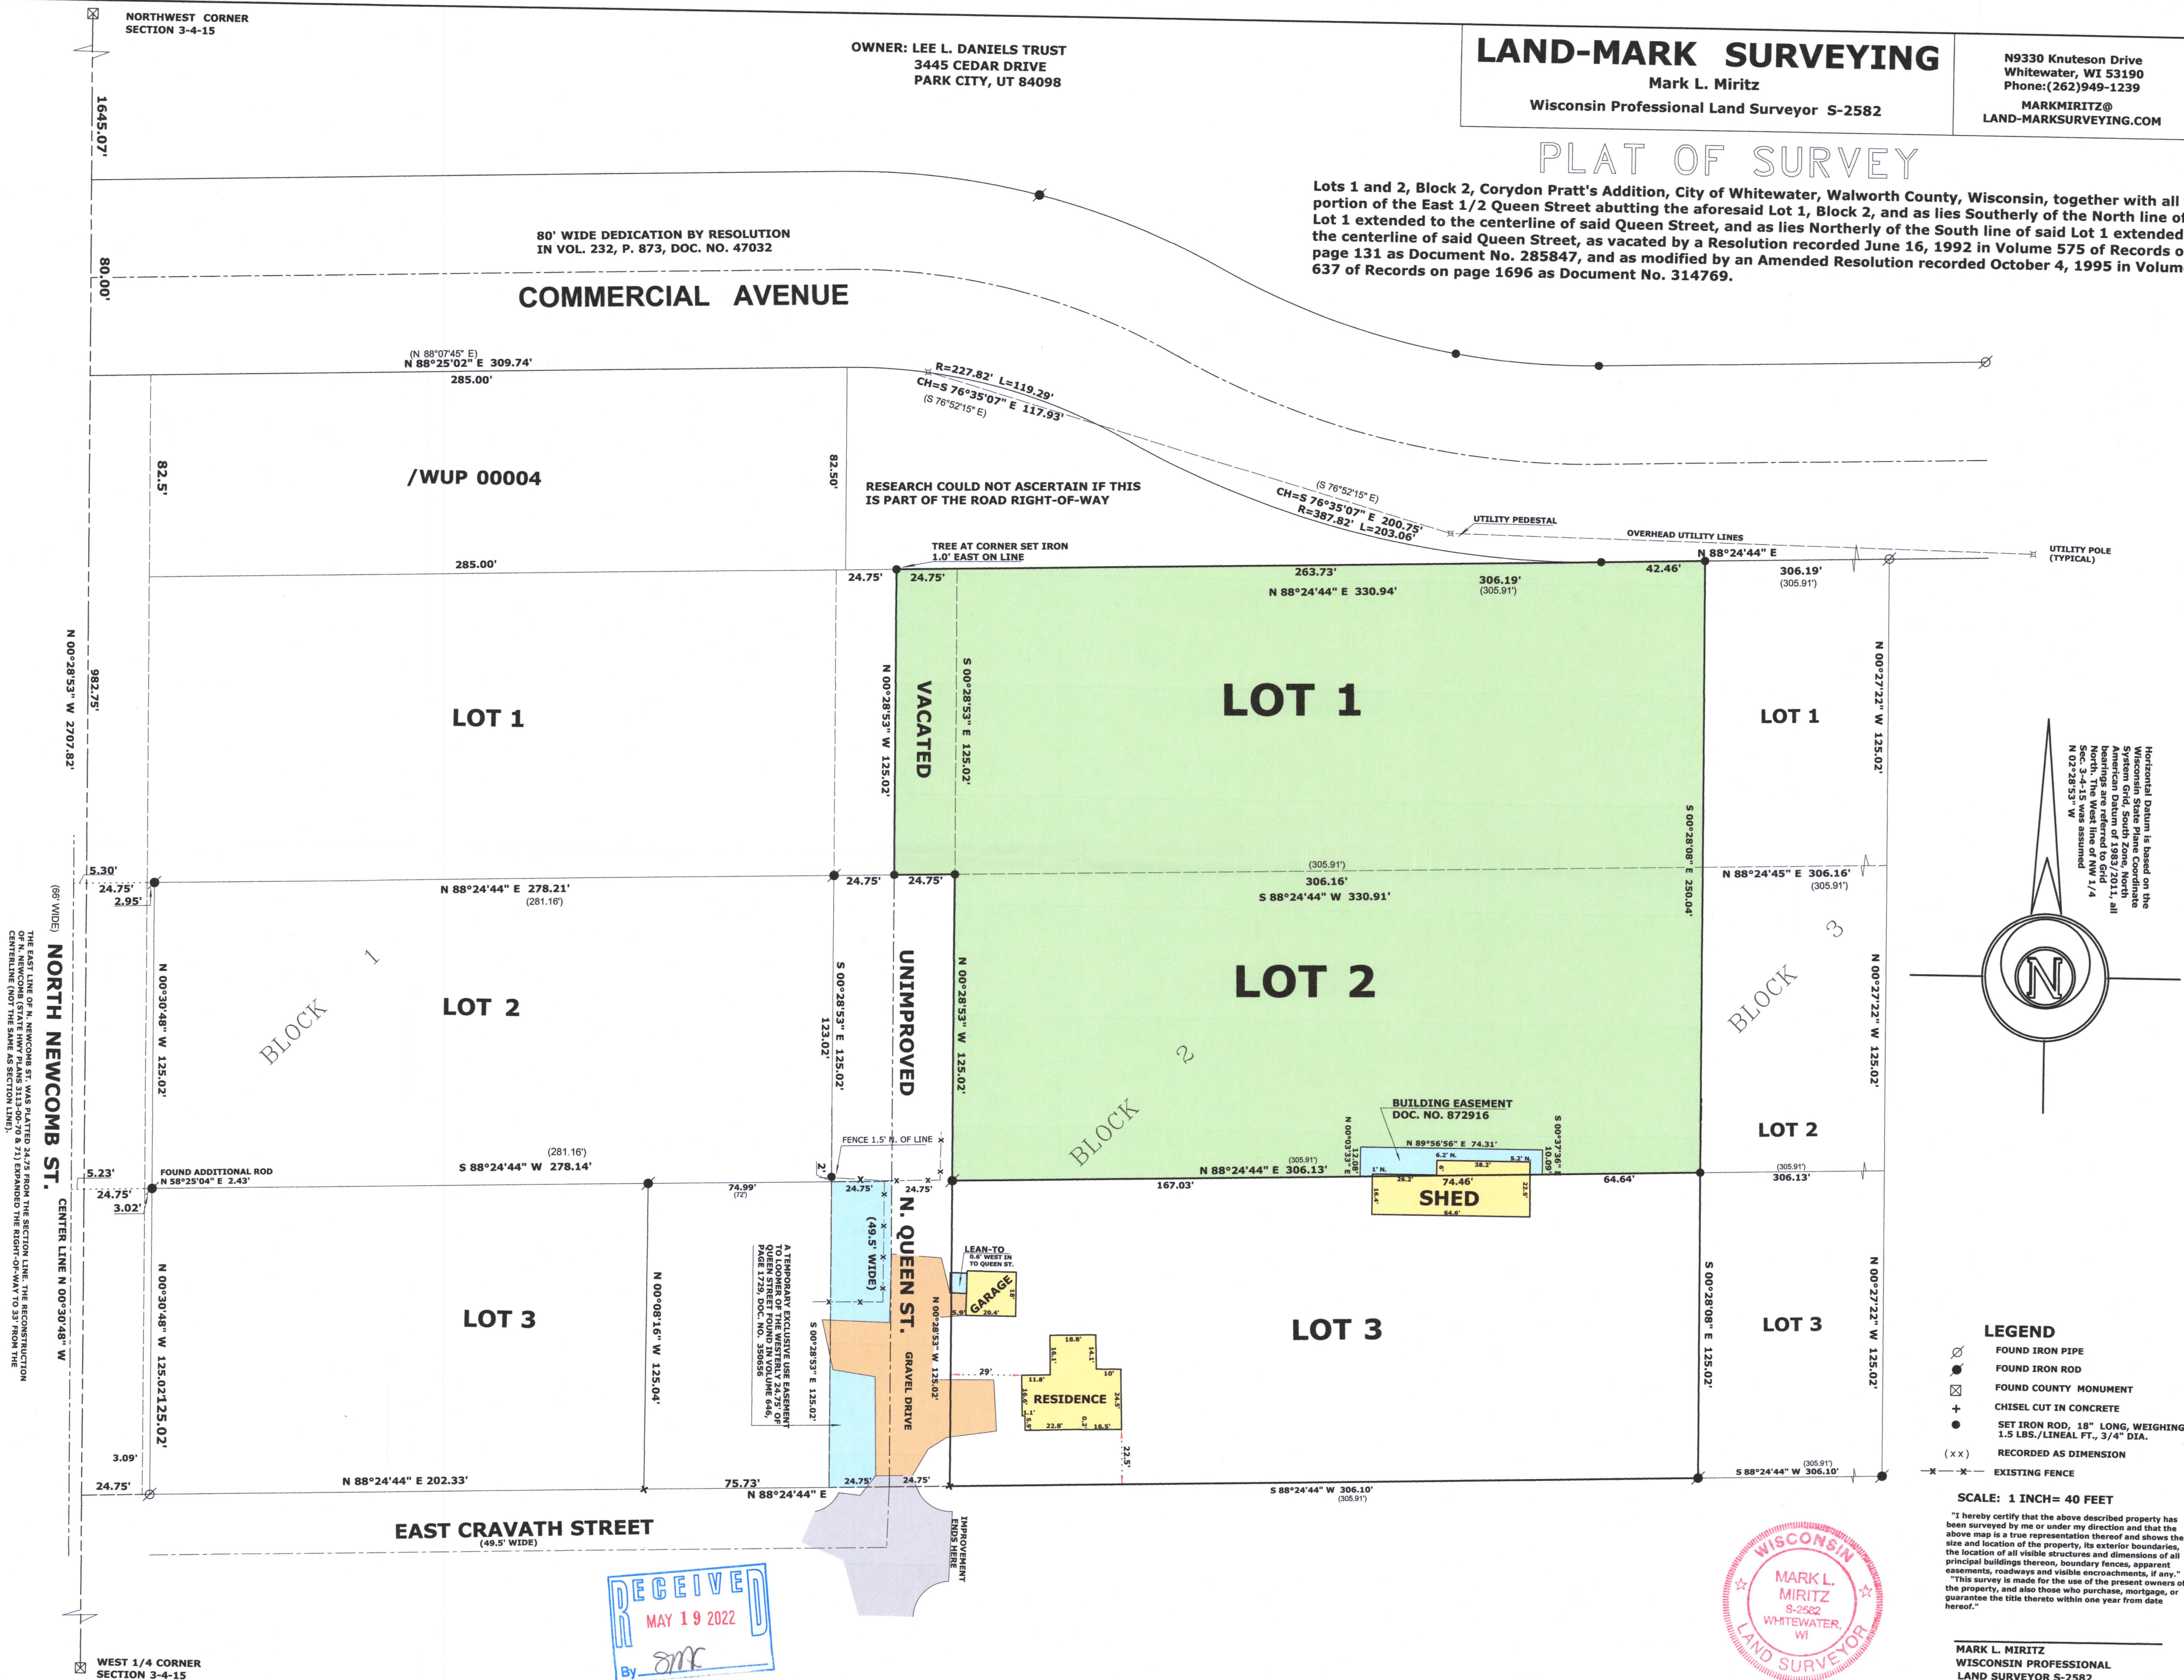

SCALE: 1 INCH= 40 FEET

"I hereby certify that the above described property has been surveyed by me or under my direction and that the above map is a true representation thereof and shows the size and location of the property, its exterior boundaries, the location of all visible structures and dimensions of all principal buildings thereon, boundary fences, apparent easements, roadways and visible encroachments, if any."

"This survey is made for the use of the present owners of the property, and also those who purchase, mortgage, or otherwise take the title thereto within one year from date hereof."

MARK L. MIRITZ
WISCONSIN PROFESSIONAL
LAND SURVEYOR S-2582

DATE: APRIL 12, 2022 JOB NO. 22.401