
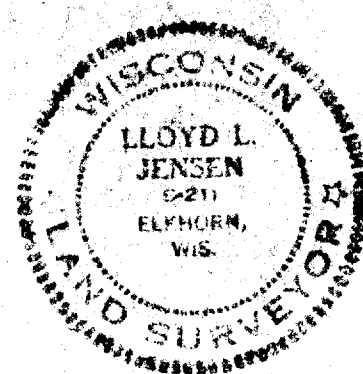


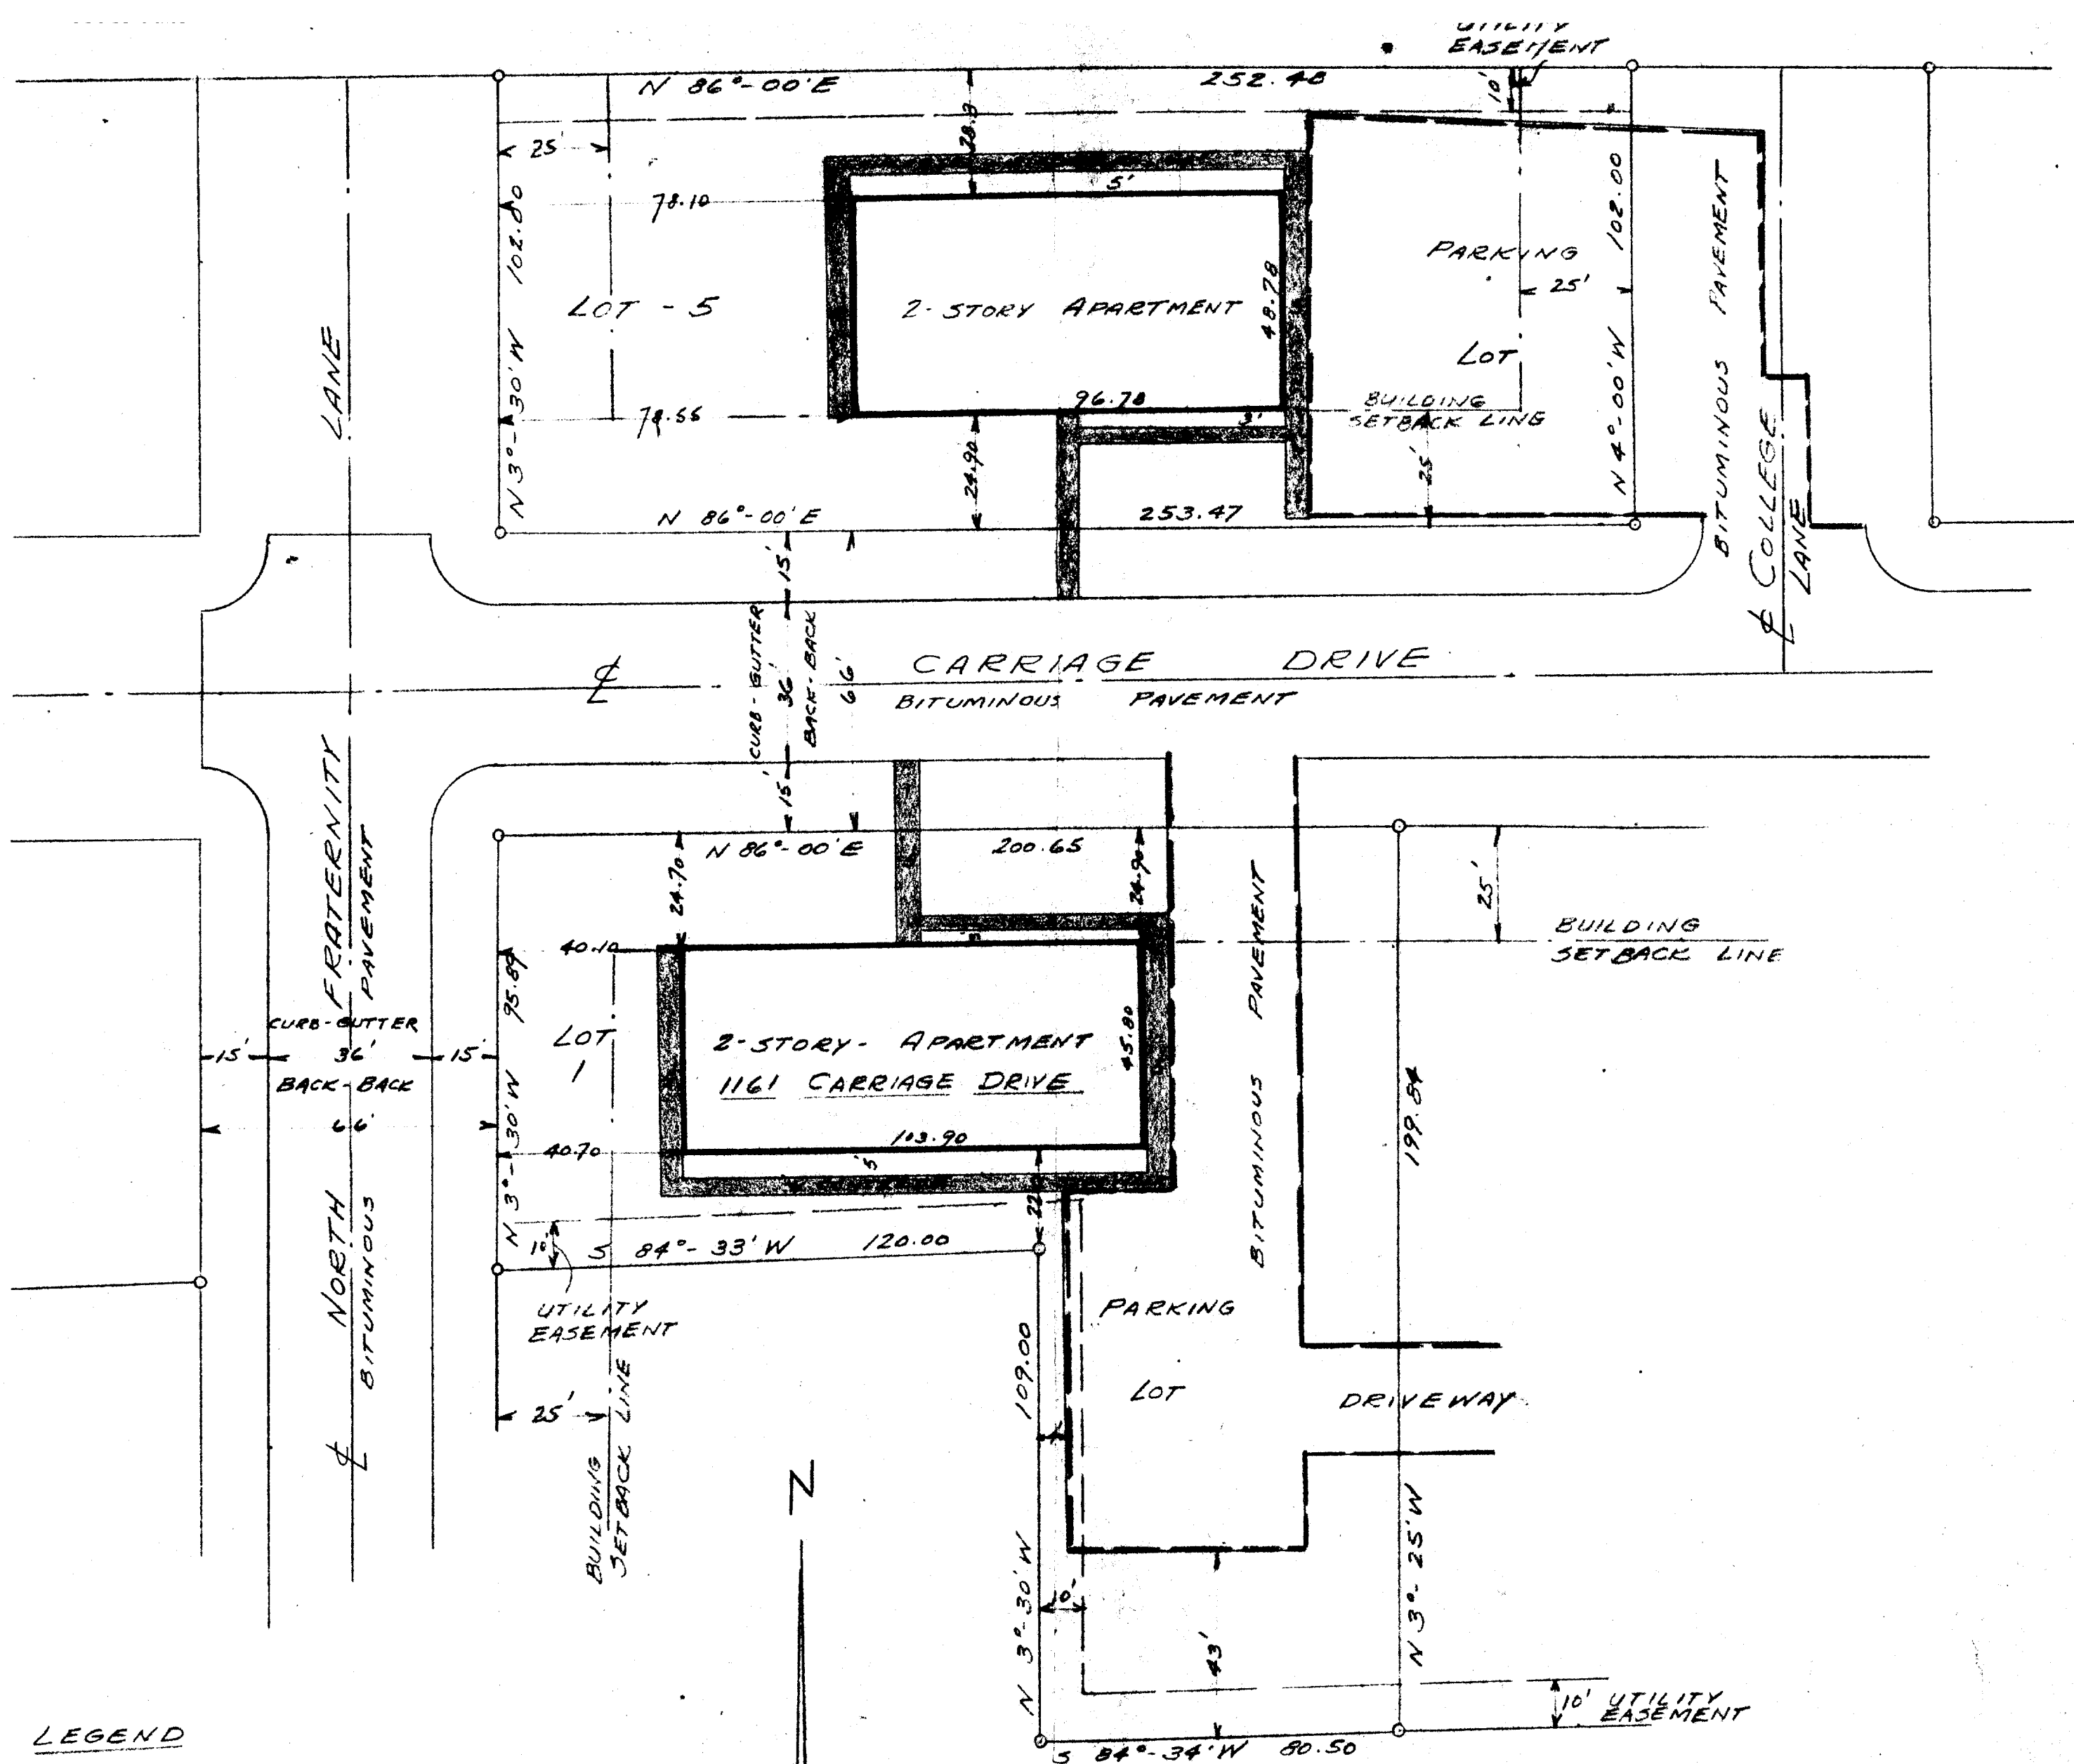

PLAT OF SURVEY
 OF
 LOT 1 AND LOT 5 CARRIAGE
 HILL SUBDIVISION - LOCATED IN
 NW 1/4 SECTION 5, T4N-R15E,
 CITY OF WHITEWATER, WALWORTH
 COUNTY, WISCONSIN.

Lloyd L. Jensen
 SURVEYOR

SCALE 1" = 30'

DATE Nov. 1966

REVISED DEC 1911

CAH-15

10-118