
REGISTERED PROFESSIONAL LAND SURVEYOR LAKE GENEVA, WISCONSIN

WILDWOOD

ROAD

96107 - Top of curb

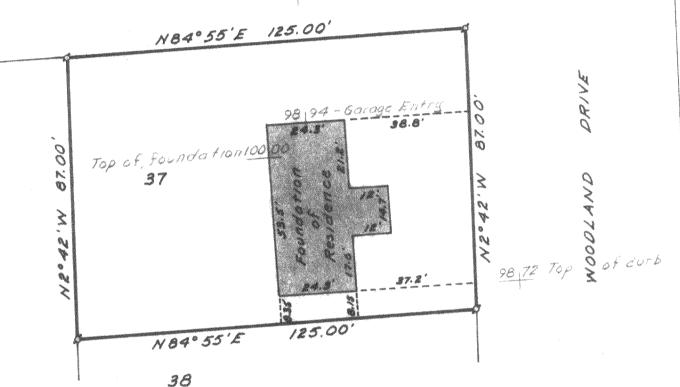

N

SCALE /"= 30"

LEGEND

Ø - IRON PIPE FOUND

O - IRON PIPE PLACED

• - CONCRETE MONUMENT

X - SPIKE

98/72-Elevation

PLAT OF SURVEY OF

Lot 37, Buckingham Estates, a subdivision located in the Southeast 1/4 of Section 6, T 4 N, R 15 E, City of Whitewater, Walworth County, Wisconsin.

I, HAROLD H. KOLB, DO HEREBY CERTIFY THAT I HAVE SURVEYED THE PROPERTY HEREON DESCRIBED ACCORDING TO THE OFFICIAL RECORDS, AND THAT THE PLAT HEREON IS A CORRECT REPRESENTATION OF THE LOT LINES, and the principle lines of the buildings thereon.

Hardol N. Holf

HAROLD H. KOLB

WISCONSIN REGISTERED LAND SURVEYOR, S-187

DATE June 25, 1966

BU-35

10-134