


HAROLD H. KOLB

REGISTERED PROFESSIONAL LAND SURVEYOR
LAKE GENEVA, WISCONSIN

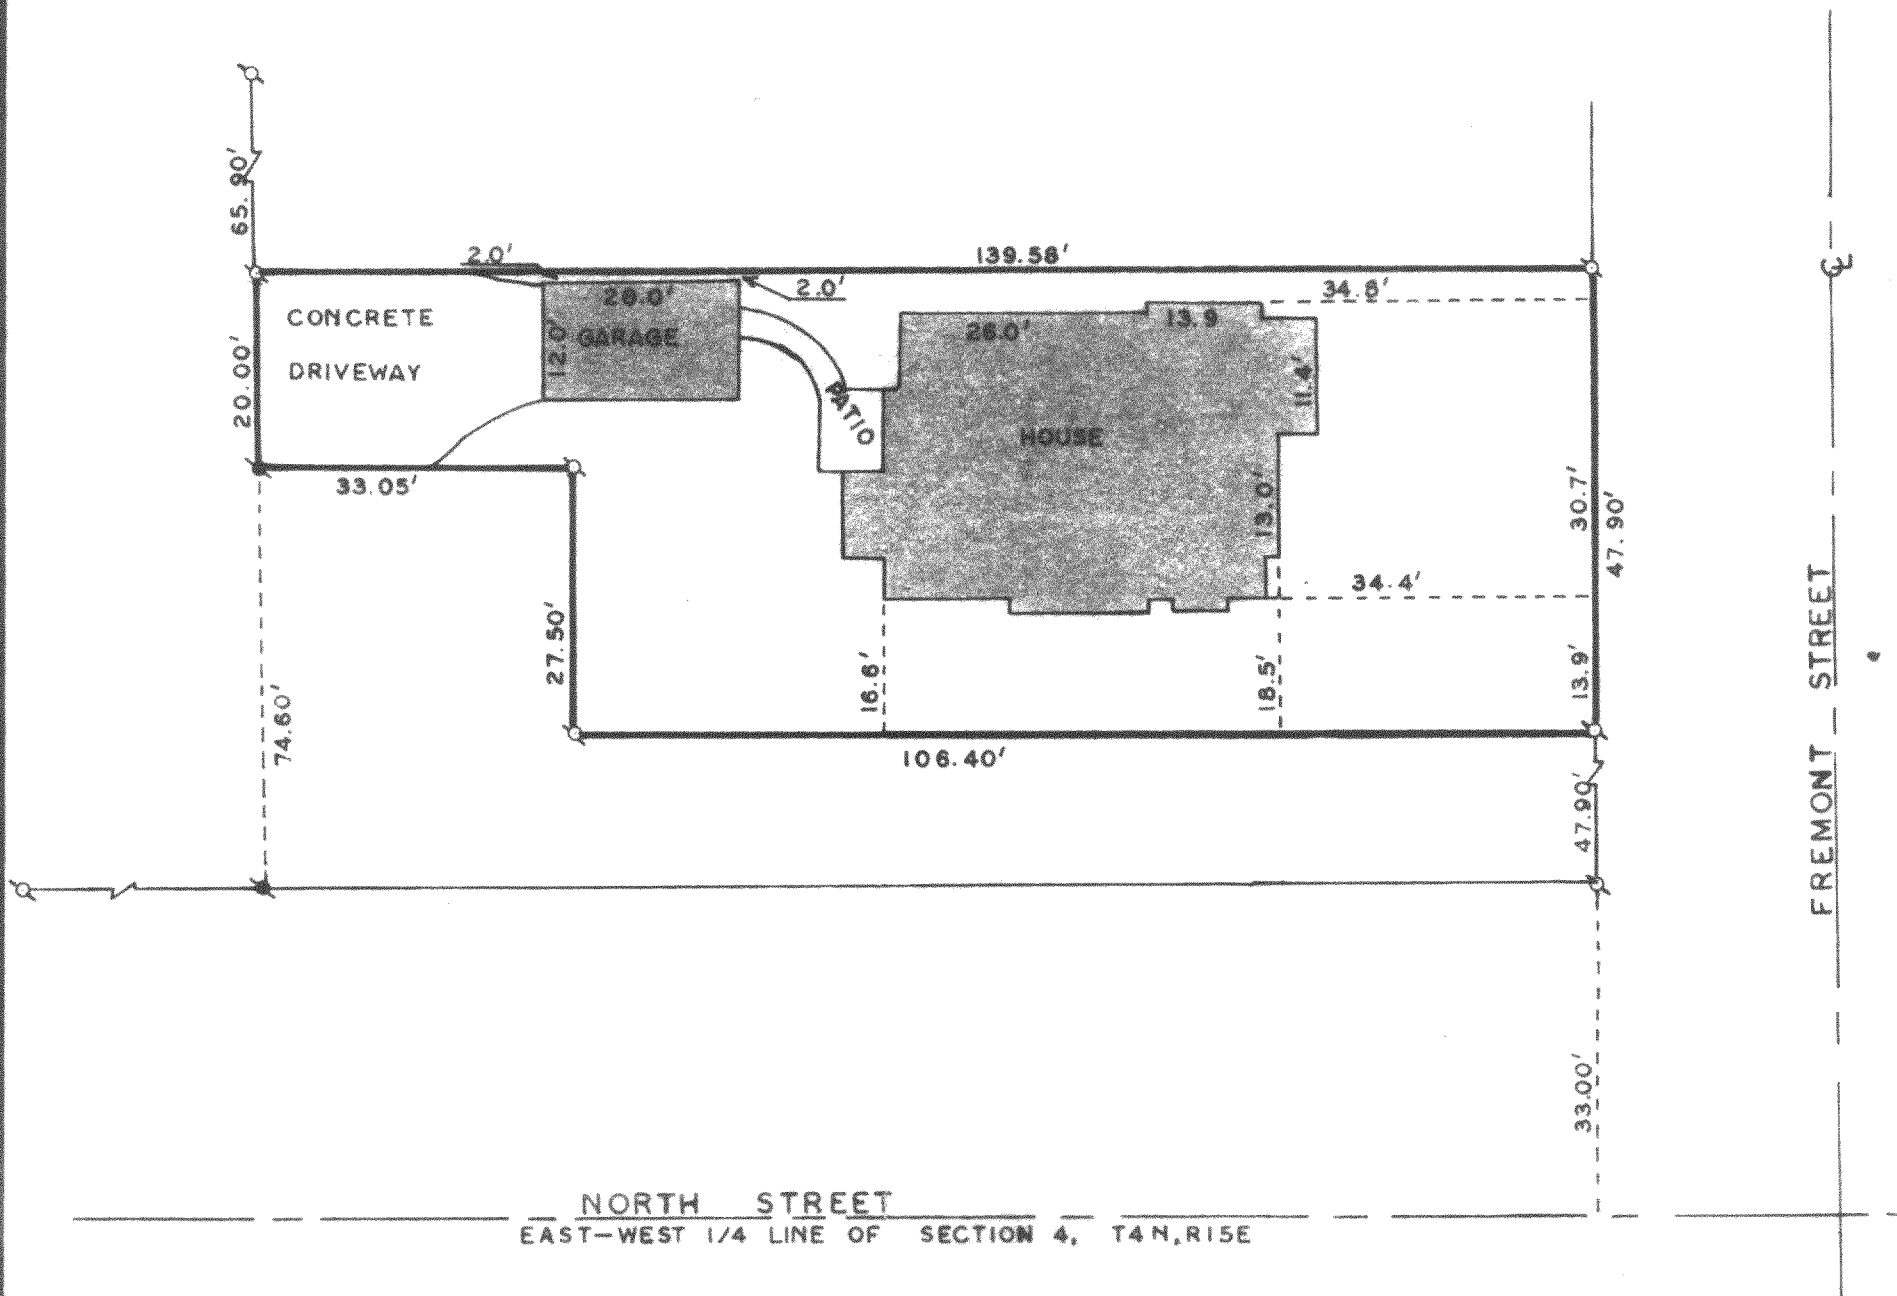

PLAT OF SURVEY OF

A parcel of land located in the Northwest
1/4 of Section 4, T 4 N, R 15 E, City of
Whitewater, Walworth County, Wisconsin,
as found to be monumented, and described as:

Part of the Northwest 1/4 of Section 4, T 4 N, R 15 E, City of Whitewater, described
as follows: Beginning, at a point on the West line of Fremont Street which is 139.58 feet
(formerly described as 7 rods 110 1/2 feet) north of the East and West 1/4 line of said
Section; thence West 139.58 feet (formerly described as 7 rods) to the North line of
lands formerly owned by Burk; thence South parallel to the West line of said Fremont
Street 12.0 feet; thence East 33.05 feet (formerly described as 33 1/10 feet) parallel to
the South line of Burk's land; thence South 27.5 feet (formerly described as 27 1/2 feet)
parallel to said West line of Fremont Street; thence East 106.4 feet (formerly described
as 40 1/10 feet) parallel to said Burk's South line to the West line of Fremont Street;
thence South to the West line of Fremont Street 47.9 feet to the point of beginning of
this description, together with and subject to a right of way contract recorded in
Volume 74 of Records on page 271 in the Walworth County, Wisconsin records.



LEGEND

- — IRON PIPE FOUND
 - — IRON PIPE PLACED
 - — CONCRETE MONUMENT
 - X — SPIKE
 - ✂ — FOUND IRON ROD
- SCALE: 1" = 20'

I, HAROLD H. KOLB, DO HEREBY CERTIFY THAT I HAVE
SURVEYED THE PROPERTY HEREON DESCRIBED ACCORDING
TO THE OFFICIAL RECORDS, AND THAT THE PLAT HEREON
IS A CORRECT REPRESENTATION OF THE LOT LINES, and the
principle lines of the buildings thereon.

Harold H. Kolb

HAROLD H. KOLB
WISCONSIN REGISTERED LAND SURVEYOR, S-187
DATE July 30, 1965