


HAROLD H. KOLB

REGISTERED PROFESSIONAL LAND SURVEYOR

LAKE GENEVA, WISCONSIN

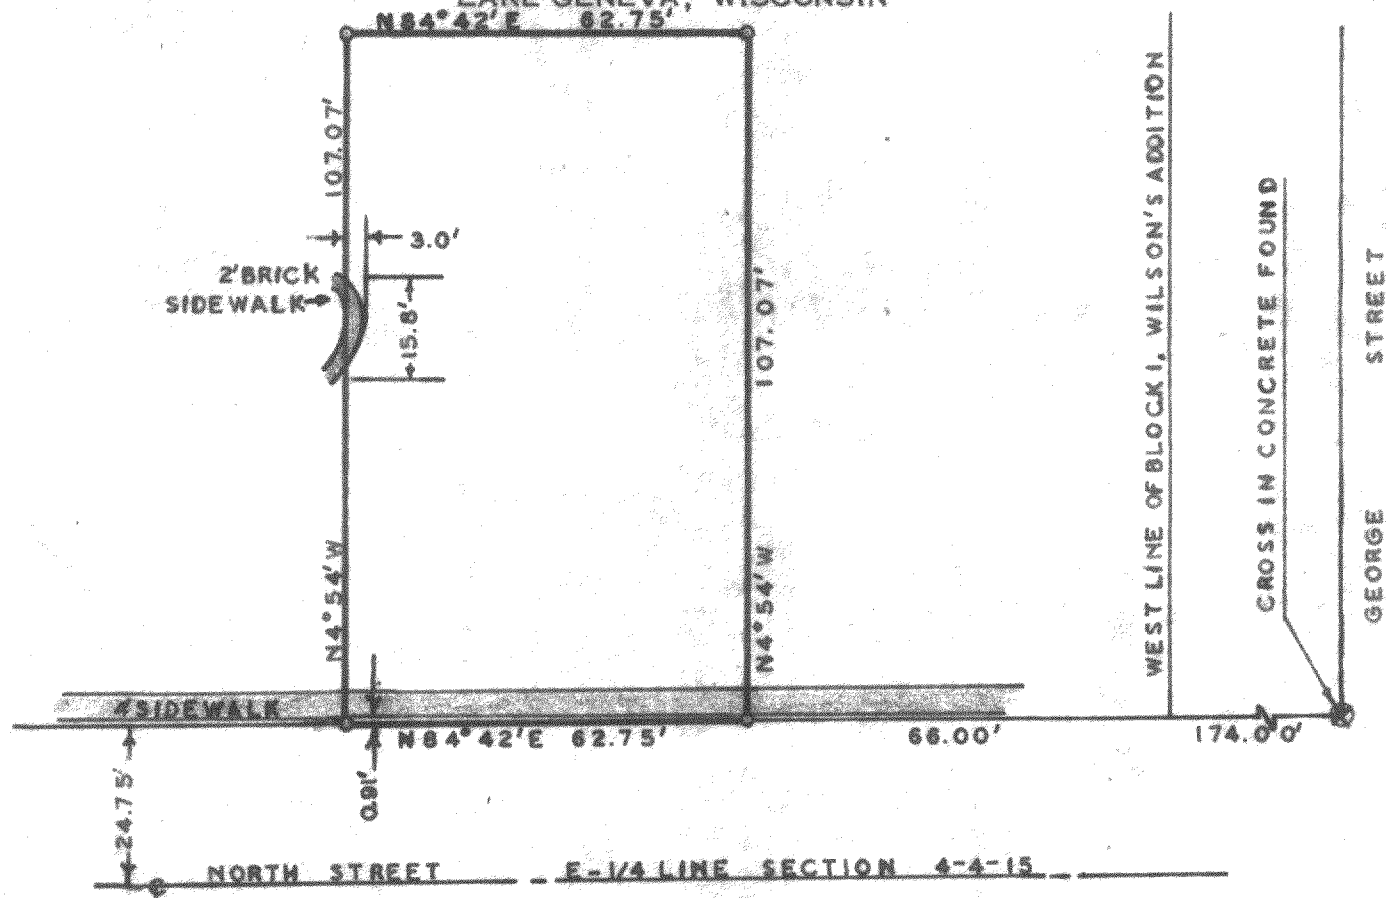

PLAT OF SURVEY OF

A parcel of land located in the Northwest 1/4 of Section 4; T 4 N, R 15 E, City of Whitewater, Walworth County, Wisconsin and described as follows; to wit: Commencing at the Southwest corner of Block 1, Wilson's Addition; thence S 84°42' W 66.00 feet to the place of beginning; thence continue S 84°42' W 62.75 feet; thence N 4°54' W 107.07 feet; thence N 84°42' E 62.75 feet; thence S 4°54' E 107.07 feet to the place of beginning.



SCALE: 1"=30'

LEGEND

- ⊂ - IRON PIPE FOUND
- - IRON PIPE PLACED
- - CONCRETE MONUMENT
- x - SPIKE

I, HAROLD H. KOLB, DO HEREBY CERTIFY THAT I HAVE SURVEYED THE PROPERTY HEREON DESCRIBED ACCORDING TO THE OFFICIAL RECORDS, AND THAT THE PLAT HEREON IS A CORRECT REPRESENTATION OF THE LOT LINES.

Harold H. Kolb

HAROLD H. KOLB

WISCONSIN REGISTERED LAND SURVEYOR, S-187

DATE December 19, 1966

10-145

UP-67