
## HAROLD H. KOLB

REGISTERED PROFESSIONAL LAND SURVEYOR LAKE GENEVA, WISCONSIN

HIGH STREET

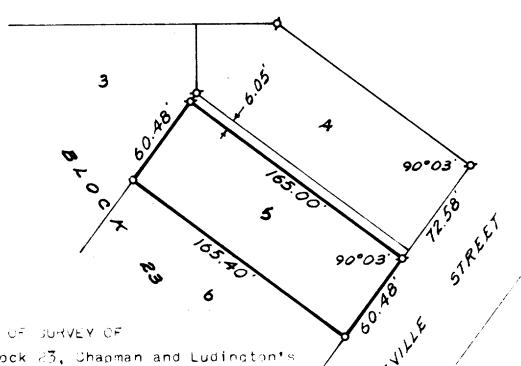

PLAT OF SURVEY OF

Part of Lot 5, Block 23, Chapman and Ludington's Addition to the City of Whitewater, Nalworth County, wisconsin.




## **LEGEND**

Ø - IRON PIPE FOUND

o - IRON Fod PLACED

• - CONCRETE MONUMENT

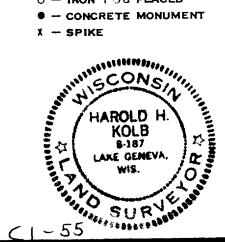

I, HAROLD H. KOLB, DO HEREBY CERTIFY THAT I HAVE SURVEYED THE PROPERTY HEREON DESCRIBED ACCORDING TO THE OFFICIAL RECORDS, AND THAT THE PLAT HEREON IS A CORRECT REPRESENTATION OF THE LOT LINES.

WISCONSIN REGISTERED LAND SURVEYOR, S-187

May 26, 1969 DATE

10-169