


Center of Section
3, T4N, R15E

HAROLD H. KOLB

REGISTERED PROFESSIONAL LAND SURVEYOR
LAKE GENEVA, WISCONSIN

PLAT OF SURVEY OF

A parcel of land located
in the Southeast 1/4 of
Section 3, T 4 N, R 15 E,
Walworth County, Wisconsin
and as described in Vol.
466 of deeds, page 191,
Walworth County Register
of Deeds and more particul-
arly described as follows;
to wit:
Commencing at the Center
of said Section 3; thence
S 1°23' W 922.05 feet;
thence S 86°10' E 137.12
feet to the place of
beginning; thence Continue
S 86°10' E 110.60 feet;
thence S 1°23' W 80.81
feet; thence S 75°12' W
115.06 feet; thence N 1°
23' E 117.61 feet to the
place of beginning.

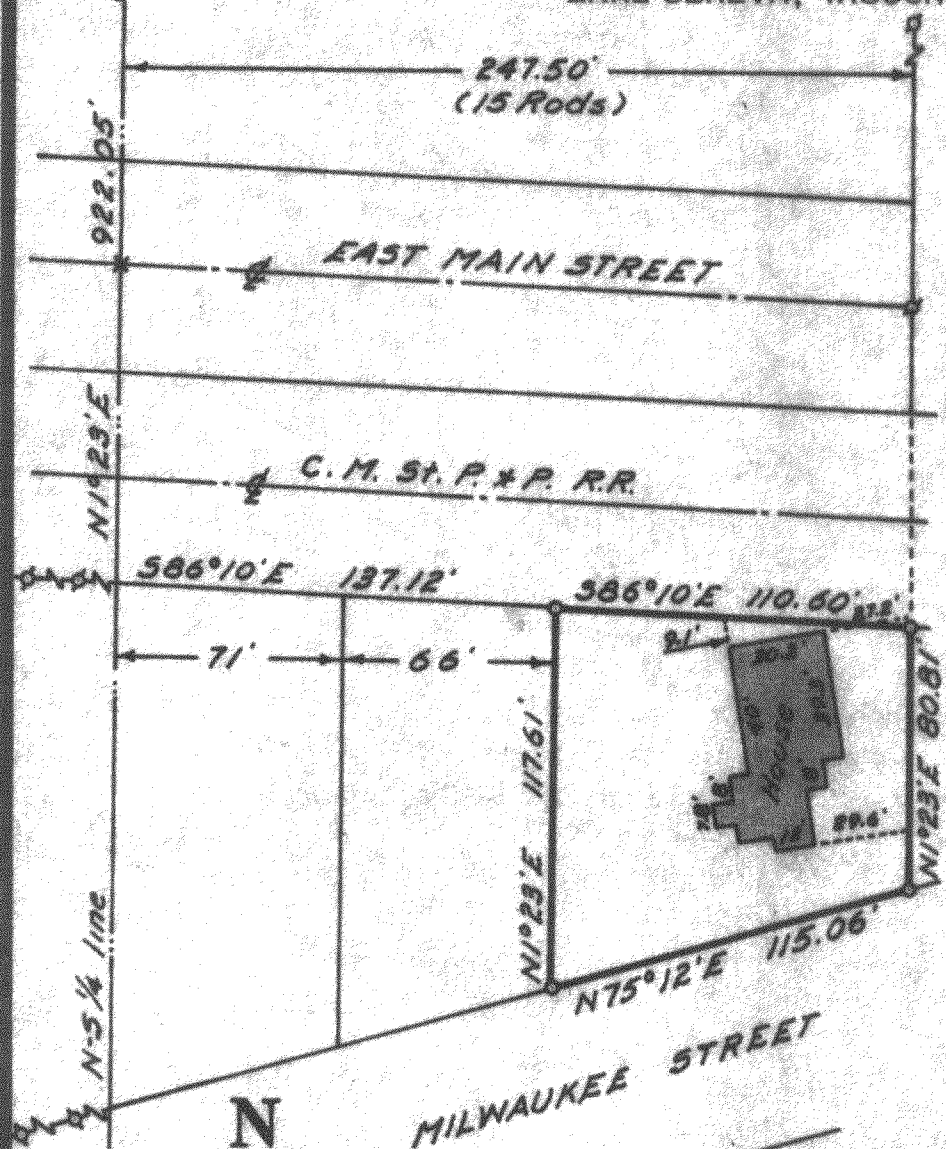

N
SCALE: 1"=60'
LEGEND

- Ø - IRON PIPE FOUND
- - IRON PIPE PLACED
- - CONCRETE MONUMENT FOUND
- X - SPIKE

I, HAROLD H. KOLB, DO HEREBY CERTIFY THAT I HAVE
SURVEYED THE PROPERTY HEREON DESCRIBED ACCORDING
TO THE OFFICIAL RECORDS, AND THAT THE PLAT HEREON
IS A CORRECT REPRESENTATION OF THE LOT LINES, and the
principle lines of the buildings thereon.

Harold H. Kolb
HAROLD H. KOLB

WISCONSIN REGISTERED LAND SURVEYOR, S-187

DATE March 28, 1966

UP-6B

HAS-68

10-183