



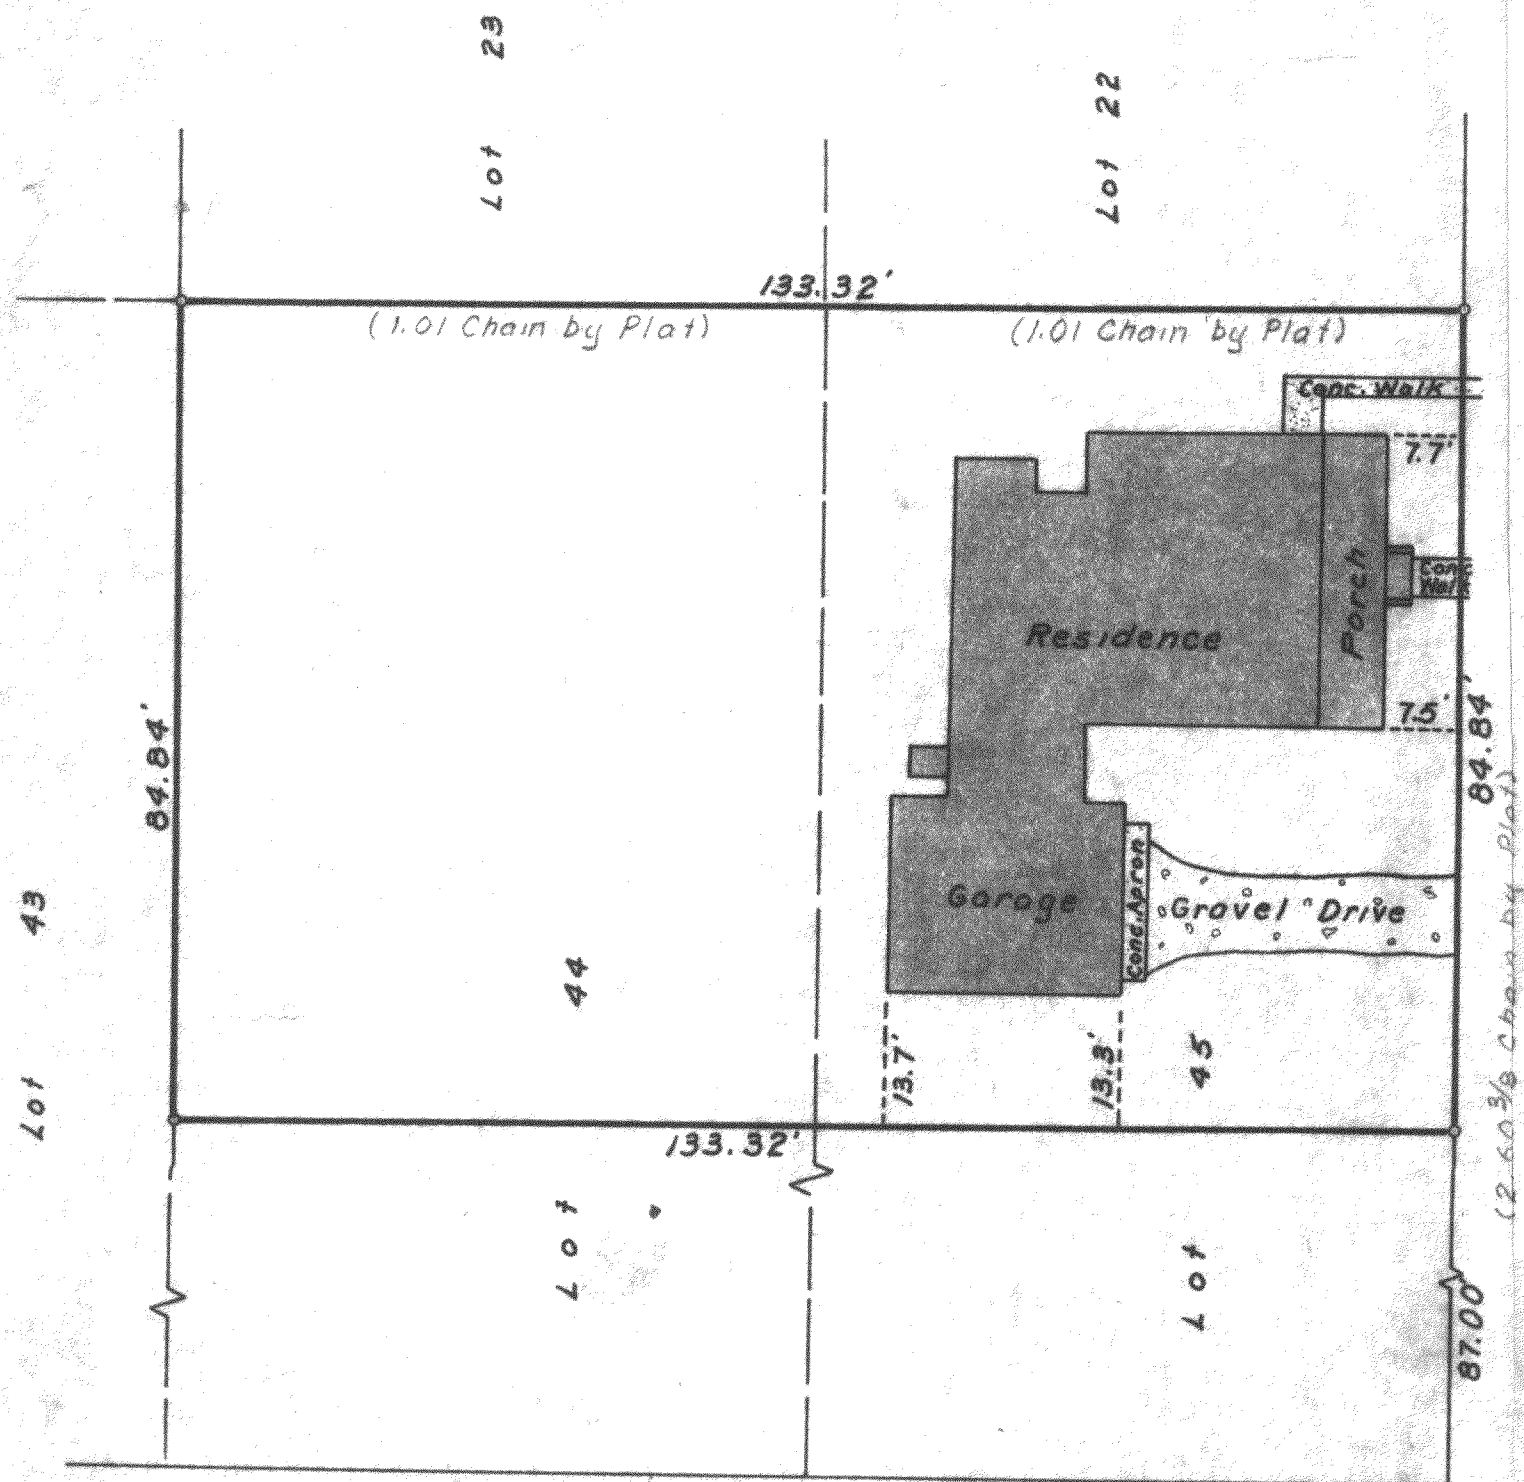

WHITON STREET
(60' Wide)

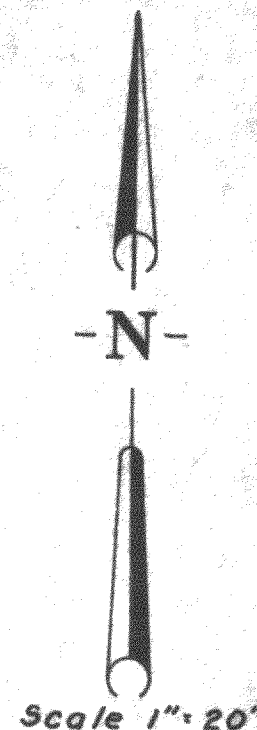

PLAT OF SURVEY OF

Part of Lots 44 & 45, Hanford A. Conger's Subdivision of Block 6 of Birge's Addition to the City of Whitewater, Walworth County, Wisconsin.

State of Wisconsin)
County of Walworth) SS

I, Harold H. Kolb, do hereby certify that I have surveyed the property hereon described according to the official records, and that the plat hereon is a correct representation of the lot lines and the principal lines of the buildings thereon.

Harold H. Kolb
Harold H. Kolb, Wisconsin Surveyor, S-187

Date: June 1, 1963

I, Harold H. Kolb, do hereby certify that I have resurveyed the property hereon described, according to the official records, and that the plat hereon is a correct representation of the lot lines and the principle lines of the improvements thereon.

Harold H. Kolb
Harold H. Kolb, Wisconsin Surveyor, S-187
Date Revised March 1, 1967

