


HAROLD H. KOLB
REGISTERED PROFESSIONAL LAND SURVEYOR
LAKE GENEVA, WISCONSIN

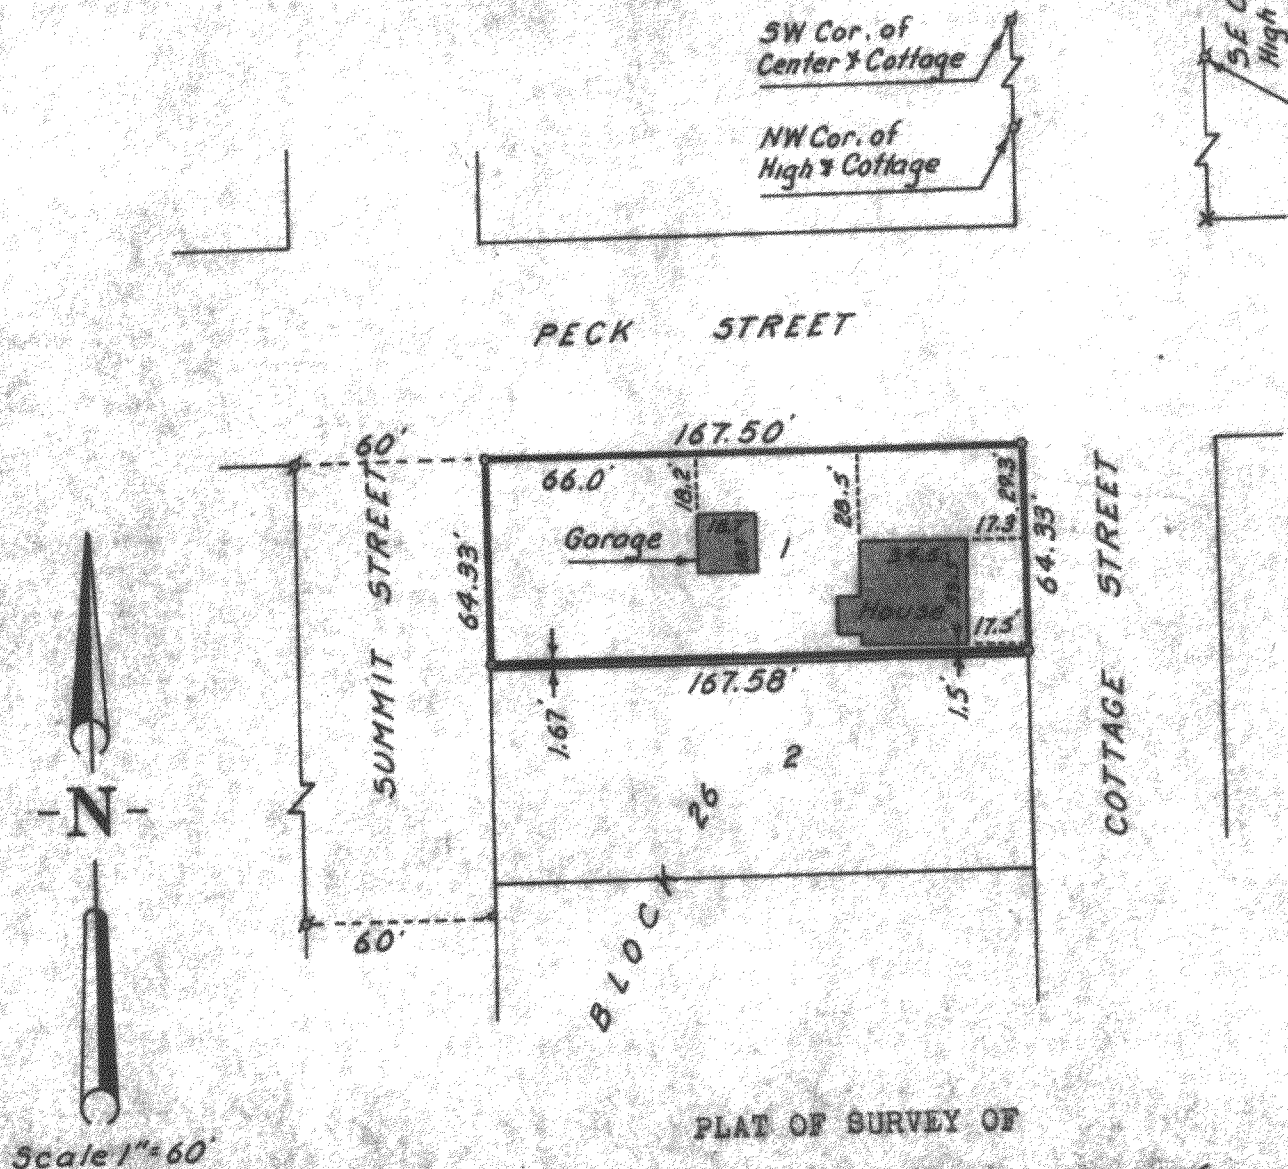

PLAT OF SURVEY OF

The North 64.33 feet of Lot 1, Block 26,
Chapman & Ludington's Addition to the
Village (Now City) of Whitewater,
Walworth County, Wisconsin.

Harold H. Kolb

Harold H. Kolb, Wisconsin Surveyor, S-187
DATE: December 13, 1963

NOTE: Iron pipe along Cottage Street
placed 1.00 feet West of Lot
Corners.

x - Cross in Conc. Found
p - Iron Pipe Found
o - Iron Pipe Placed

10-206

C 1 - 71 Now CS 9/3