



W WHITEWATER STREET

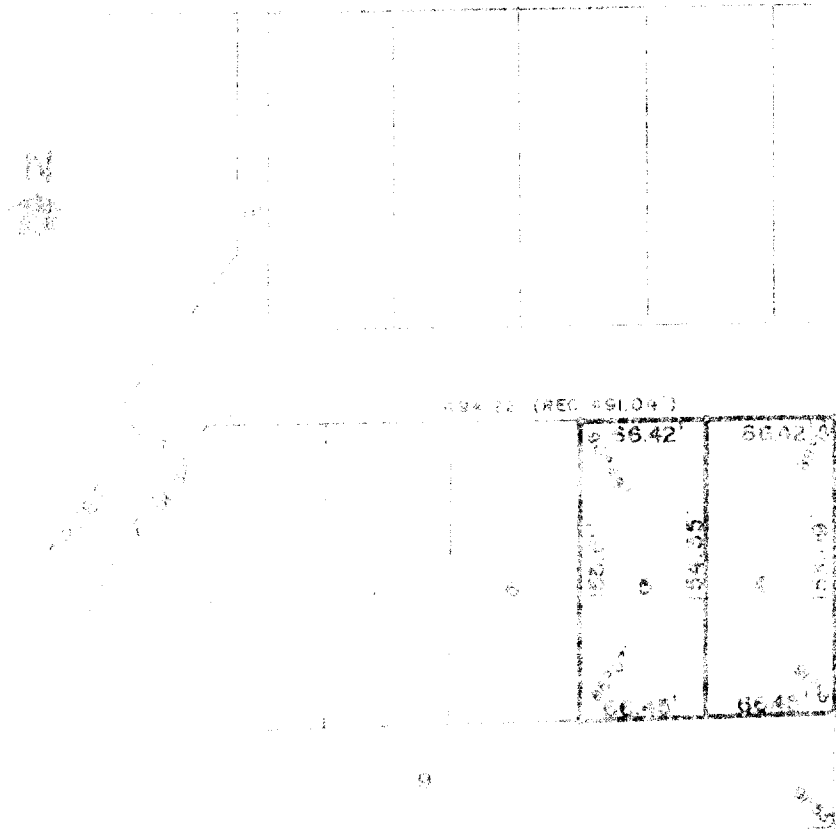

CERTIFICATE

I, [Name], a registered surveyor of the State of [State], do hereby certify that on or about April 6, 1974, I surveyed the above described land and that the same is shown on the official records and that the above is a true and correct representation to the scale of [Scale].

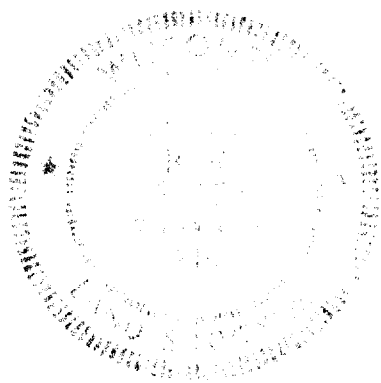

ATTEST: [Signature]

K-4 + K-4A

10-232