

PLAT OF SURVEY OF

State of Wisconsin S. S.
County of _____

I hereby certify that I have surveyed the property described above according to official records and that the plat hereon drawn correctly represents said survey and its location, that no encroachments appear from said survey except as noted hereon.

Given under my hand and seal this 1st day of JULY 1974, A.D. CAMBRIDGE Wisconsin.


of the West 1/2 of Lot 7, Block 1, Corydon
Township of Whitewater, Ch. of Whitewater,
County, Wisconsin.



LCP-10

- EXISTING IRON STAKE FOUND
- 1" X 24" IRON PIPE SET
- ✕ CHISELED CROSS SET IN CONCRETE

SCALE: 1 - 10

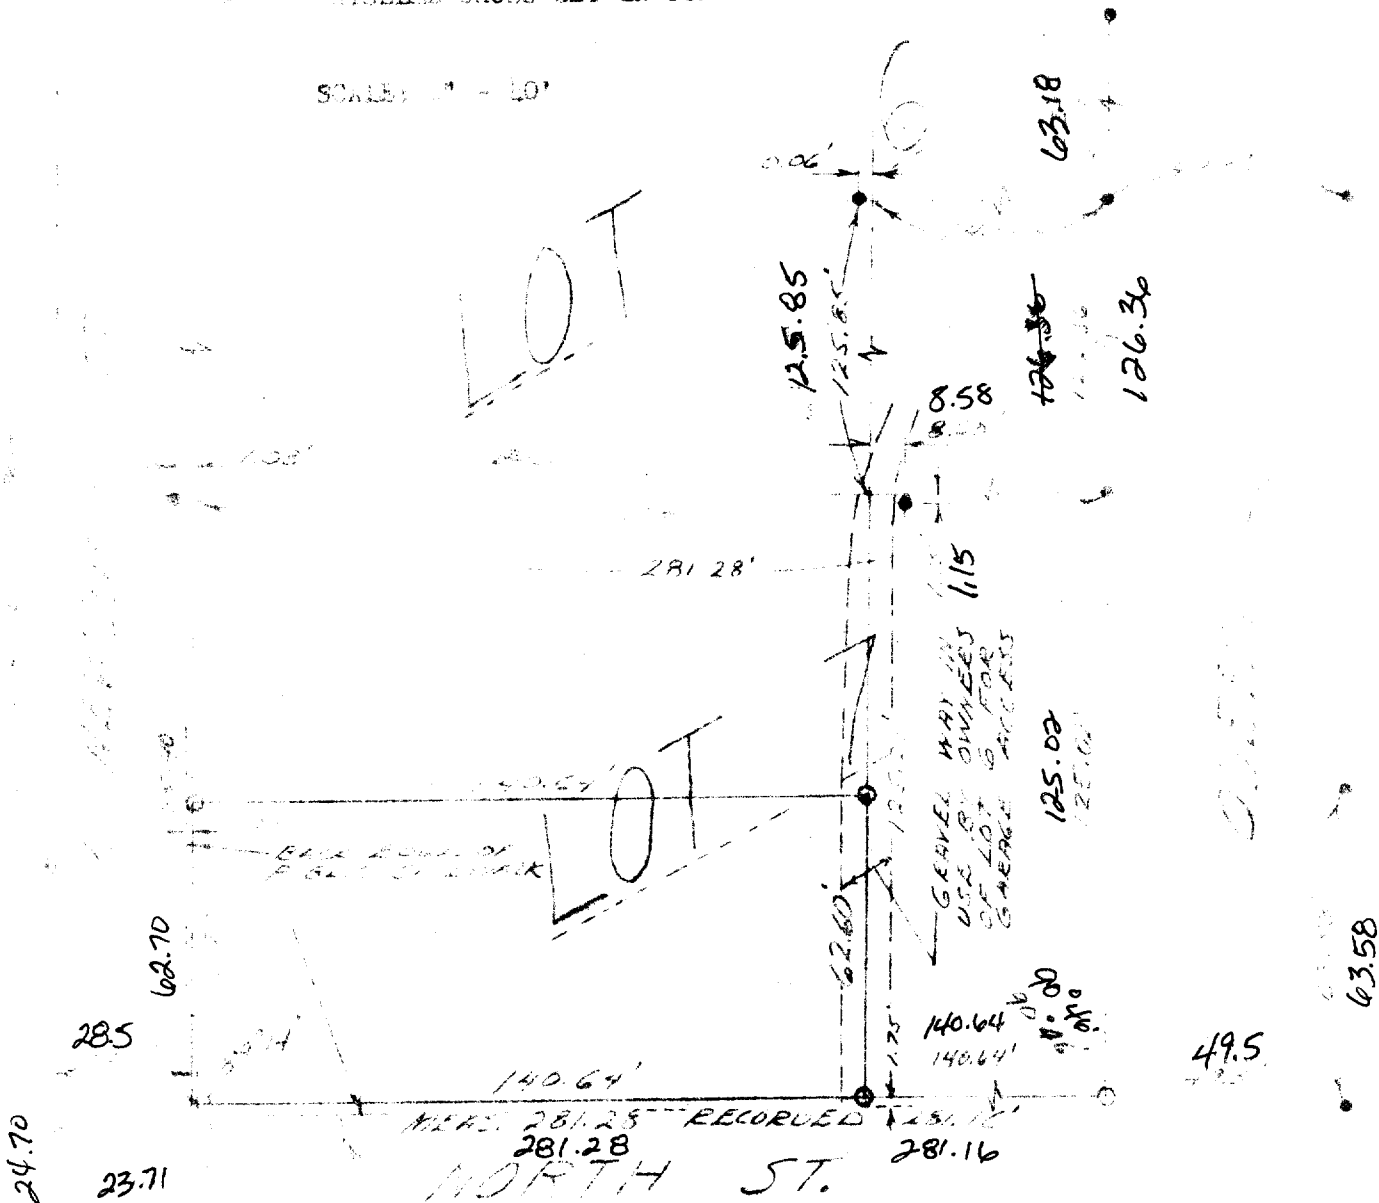

WENT TO THE FARM AT WEST
 10-11-54-4-15, LOCATION
 10-11-54-7-15 ON RECORD AT
 10-11-54-7-15.

1. The first step in the process is to identify the problem or issue that needs to be addressed. This involves gathering information and understanding the context of the problem.

NOTE: DIMENSIONS SHOWN
IN RED WERE ADDED BY
THIS OFFICE DUE IN PART
TO THE POOR QUALITY OF
SURVEY - IT DOESN'T / DIDN'T
COPY WELL - JLC

08/27/97

10-238

PC 12A