



PLAT OF SURVEY

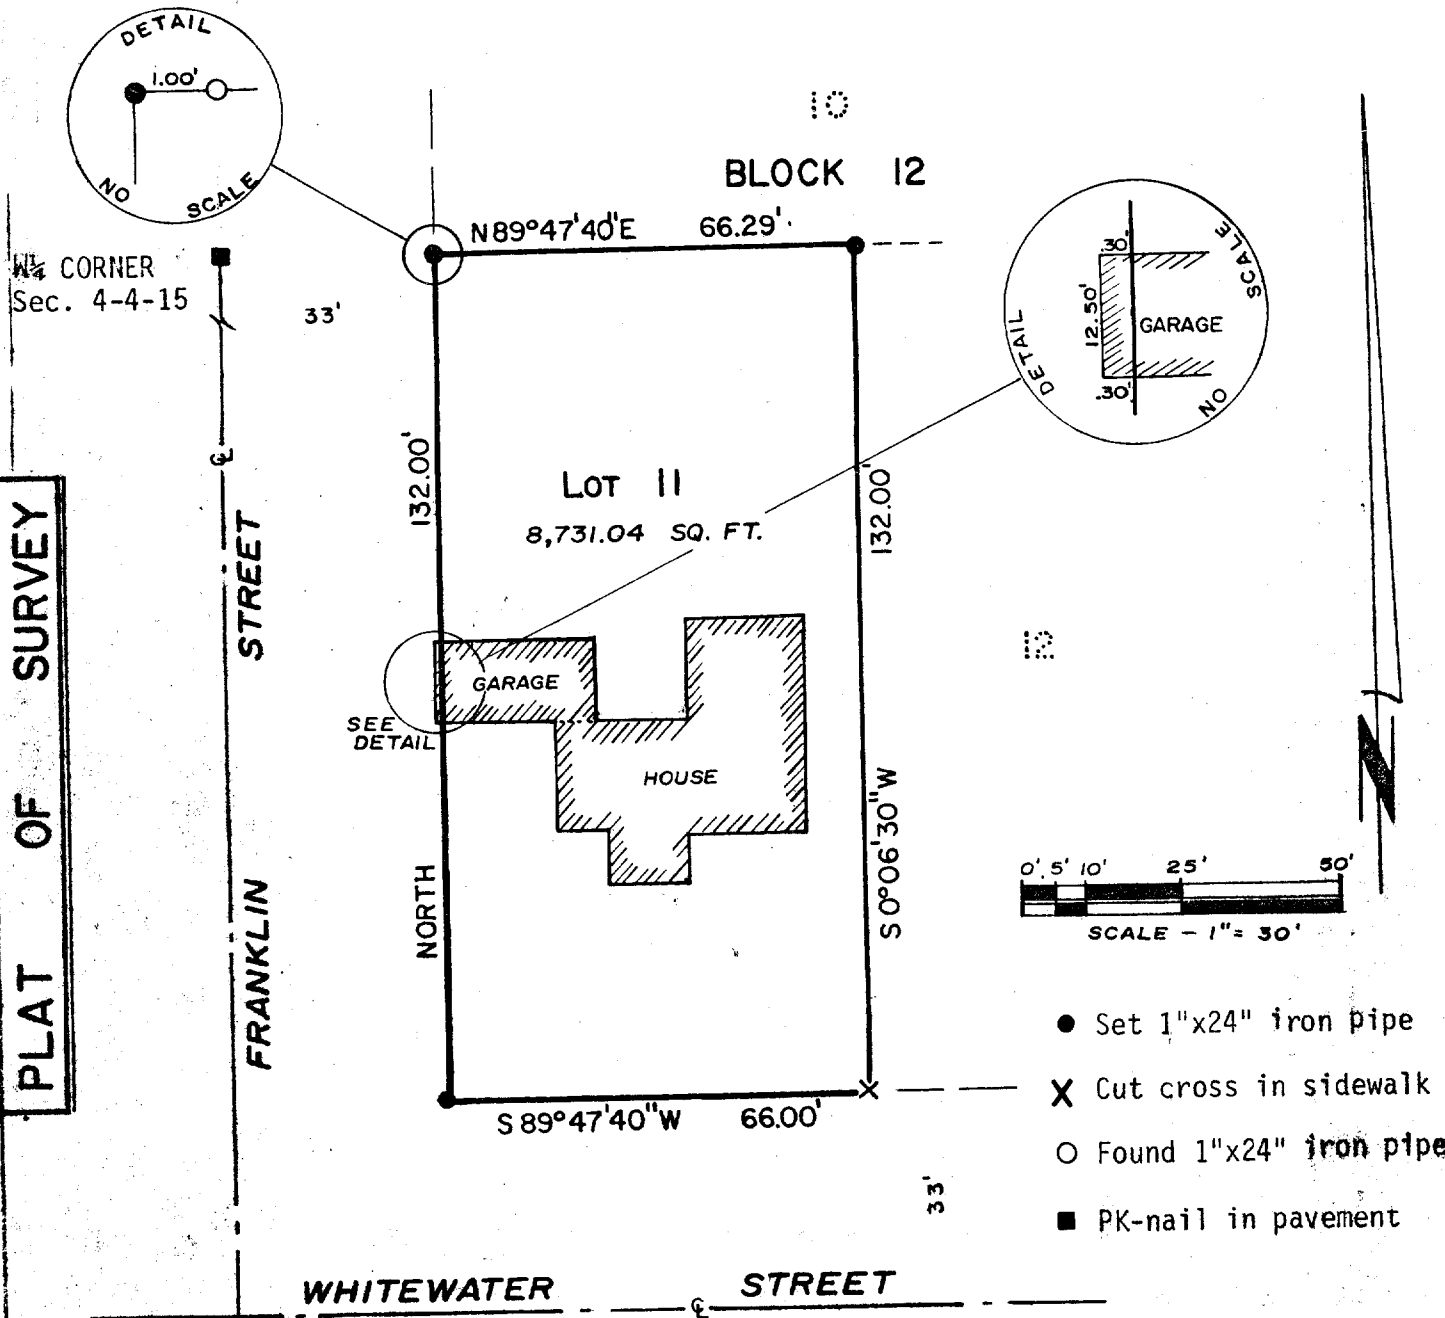

- Set 1"x24" iron pipe
- X Cut cross in sidewalk
- Found 1"x24" iron pipe
- PK-nail in pavement

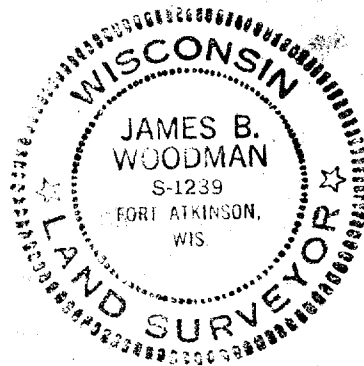

DESCRIPTION

Lot 11, Block 12, Original Plat of Whitewater, in the SW $\frac{1}{4}$ of Section 4, T4N, R15E, City of Whitewater, Walworth County, Wisconsin.

I hereby certify that I have surveyed the property described above and that this map is a correct representation of the lot lines and dimensions and the principle lines of the permanent structures thereon.

Date August 5, 1975

James B. Woodman
Wisconsin Land Surveyor S-1239

SURVEYED FOR: Mrs. Alfred Riggs
DATE SURVEYED: 7/31/75 & 8/1/75

JN 75S-70

STRAND, WOODMAN & ASSOCIATES
89 N. Main St., Fort Atkinson, Wis. 53538

Land Surveyors & Engineers
Phone (414) 563-8162

10-260