


PLAT OF SURVEY

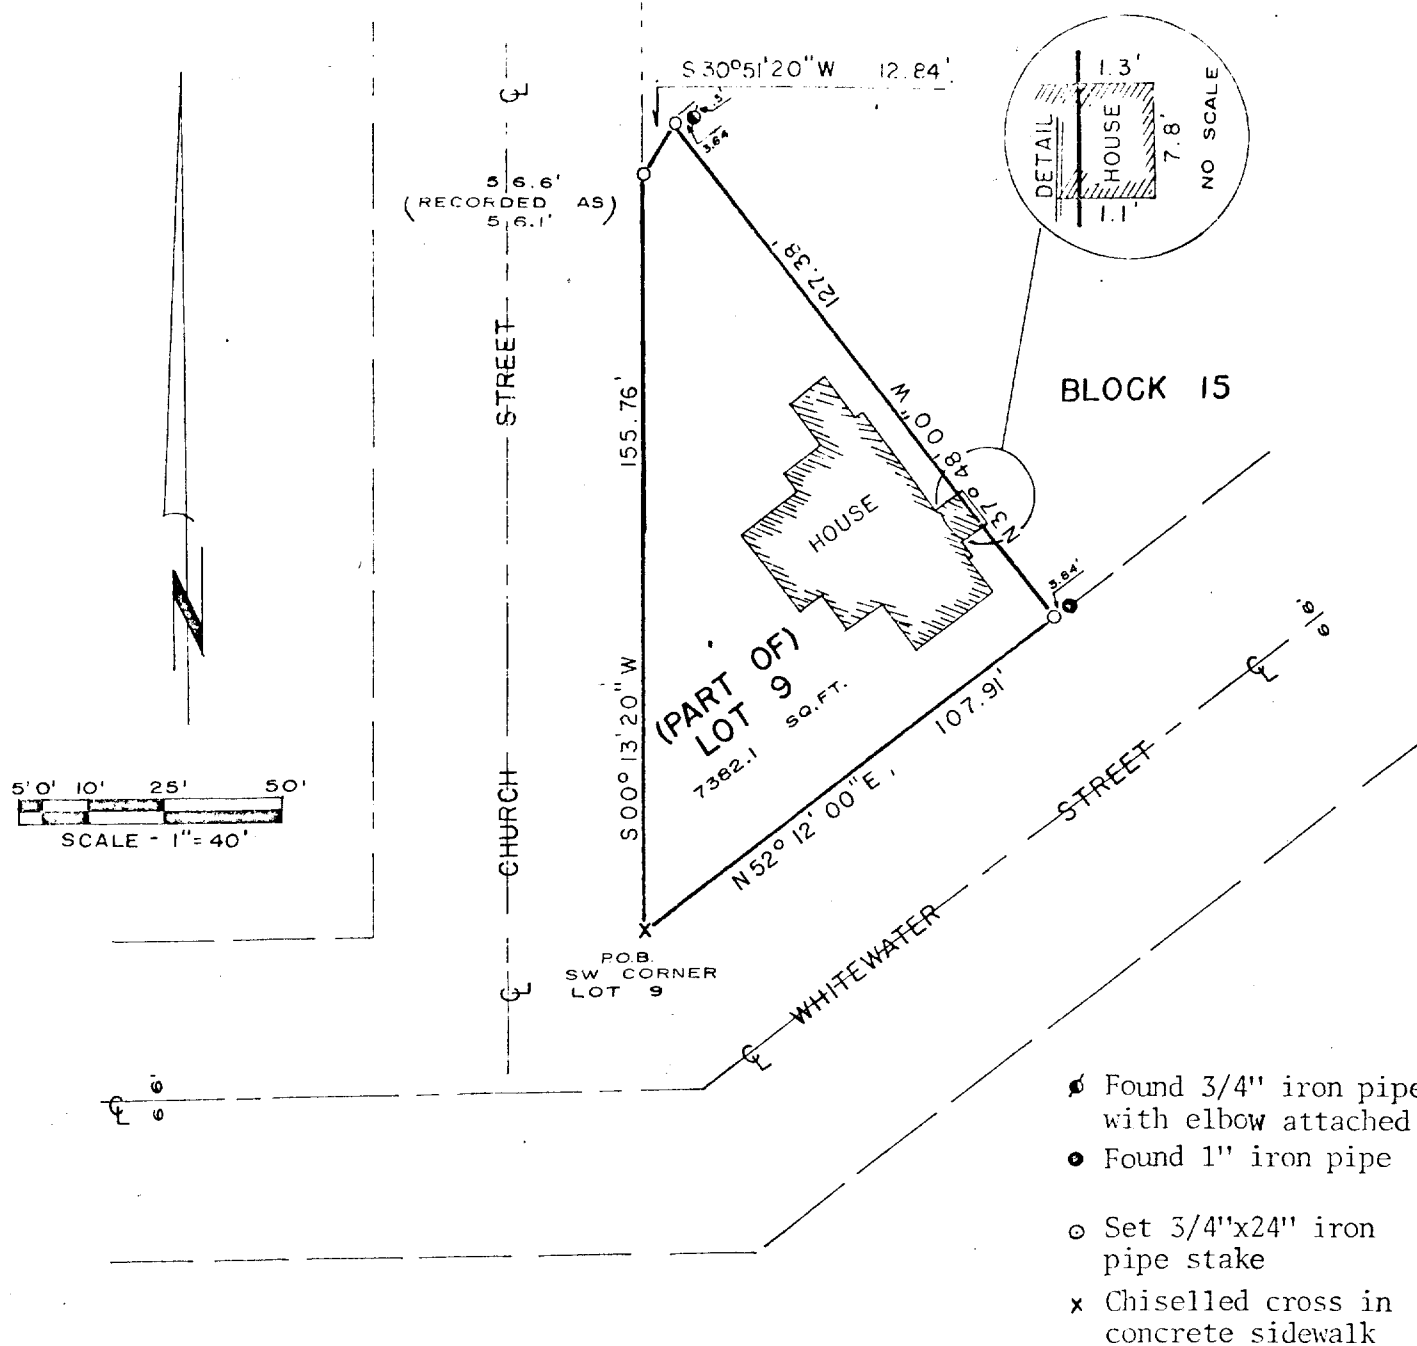

DESCRIPTION

Part of Lot 9, Block 15, Original Plat of the City of Whitewater, in the SW $\frac{1}{4}$ of Section 4, T4N, R15E, City of Whitewater, Walworth County, Wisconsin, more particularly described as follows;

Beginning at the SW Corner of said Lot 9; thence N52°12'00"E, along the north line of Whitewater Street, 107.91 ft.; thence N37°48'00"W, 127.38 ft.; thence S30°51'20"W, 12.84 ft. to the east line of Church Street; thence S0°13'20"W, along said east line, 155.76 ft. to the point of beginning.

I hereby certify that I have surveyed the property described above and that this map is a correct representation of the lot lines and dimensions and the principle lines of the permanent structures thereon.

Date 9/10/75

revised: 9/16/75

James B. Woodman
James B. Woodman
Registered Land Surveyor S-1239



Surveyed for: Donna Fero
Date surveyed: 9/2/75