



#103-68

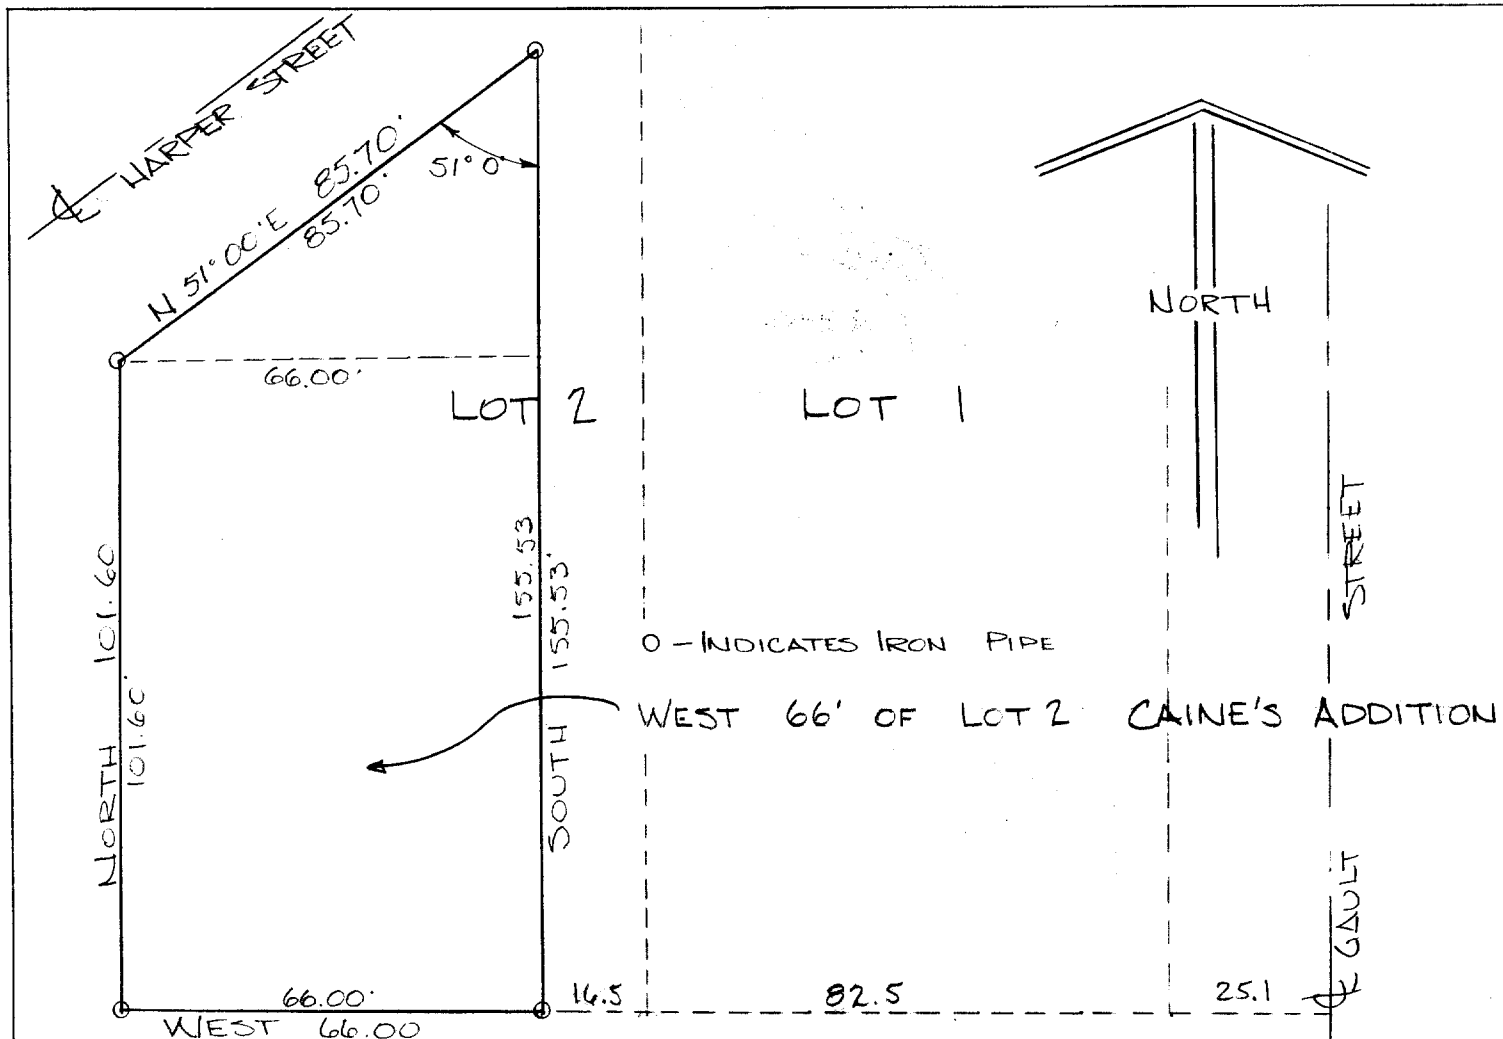

Bel 3
 Description: The West 66.00 feet of Lot #2 of Caine's Addition in the NE $\frac{1}{4}$ of Section 8, T. 4 N., R. 15 E., the City of Whitewater, Walworth County, Wisconsin.

Certificate: I, James F. Biagi, surveyor, do hereby certify that I have surveyed the property hereon described.

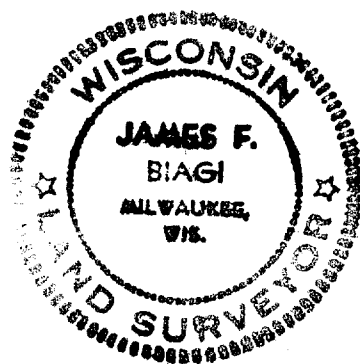

James F. Biagi
 James F. Biagi RLS 272

August 19, 1968

CA-20A

10-28B