


PLAT OF SURVEY OF
A PARCEL OF LAND LOCATED IN THE SE 1/4 OF THE NW 1/4
OF SECTION 5, T4N, R15E, CITY OF WHITEWATER,
VALWORTH COUNTY, WISCONSIN

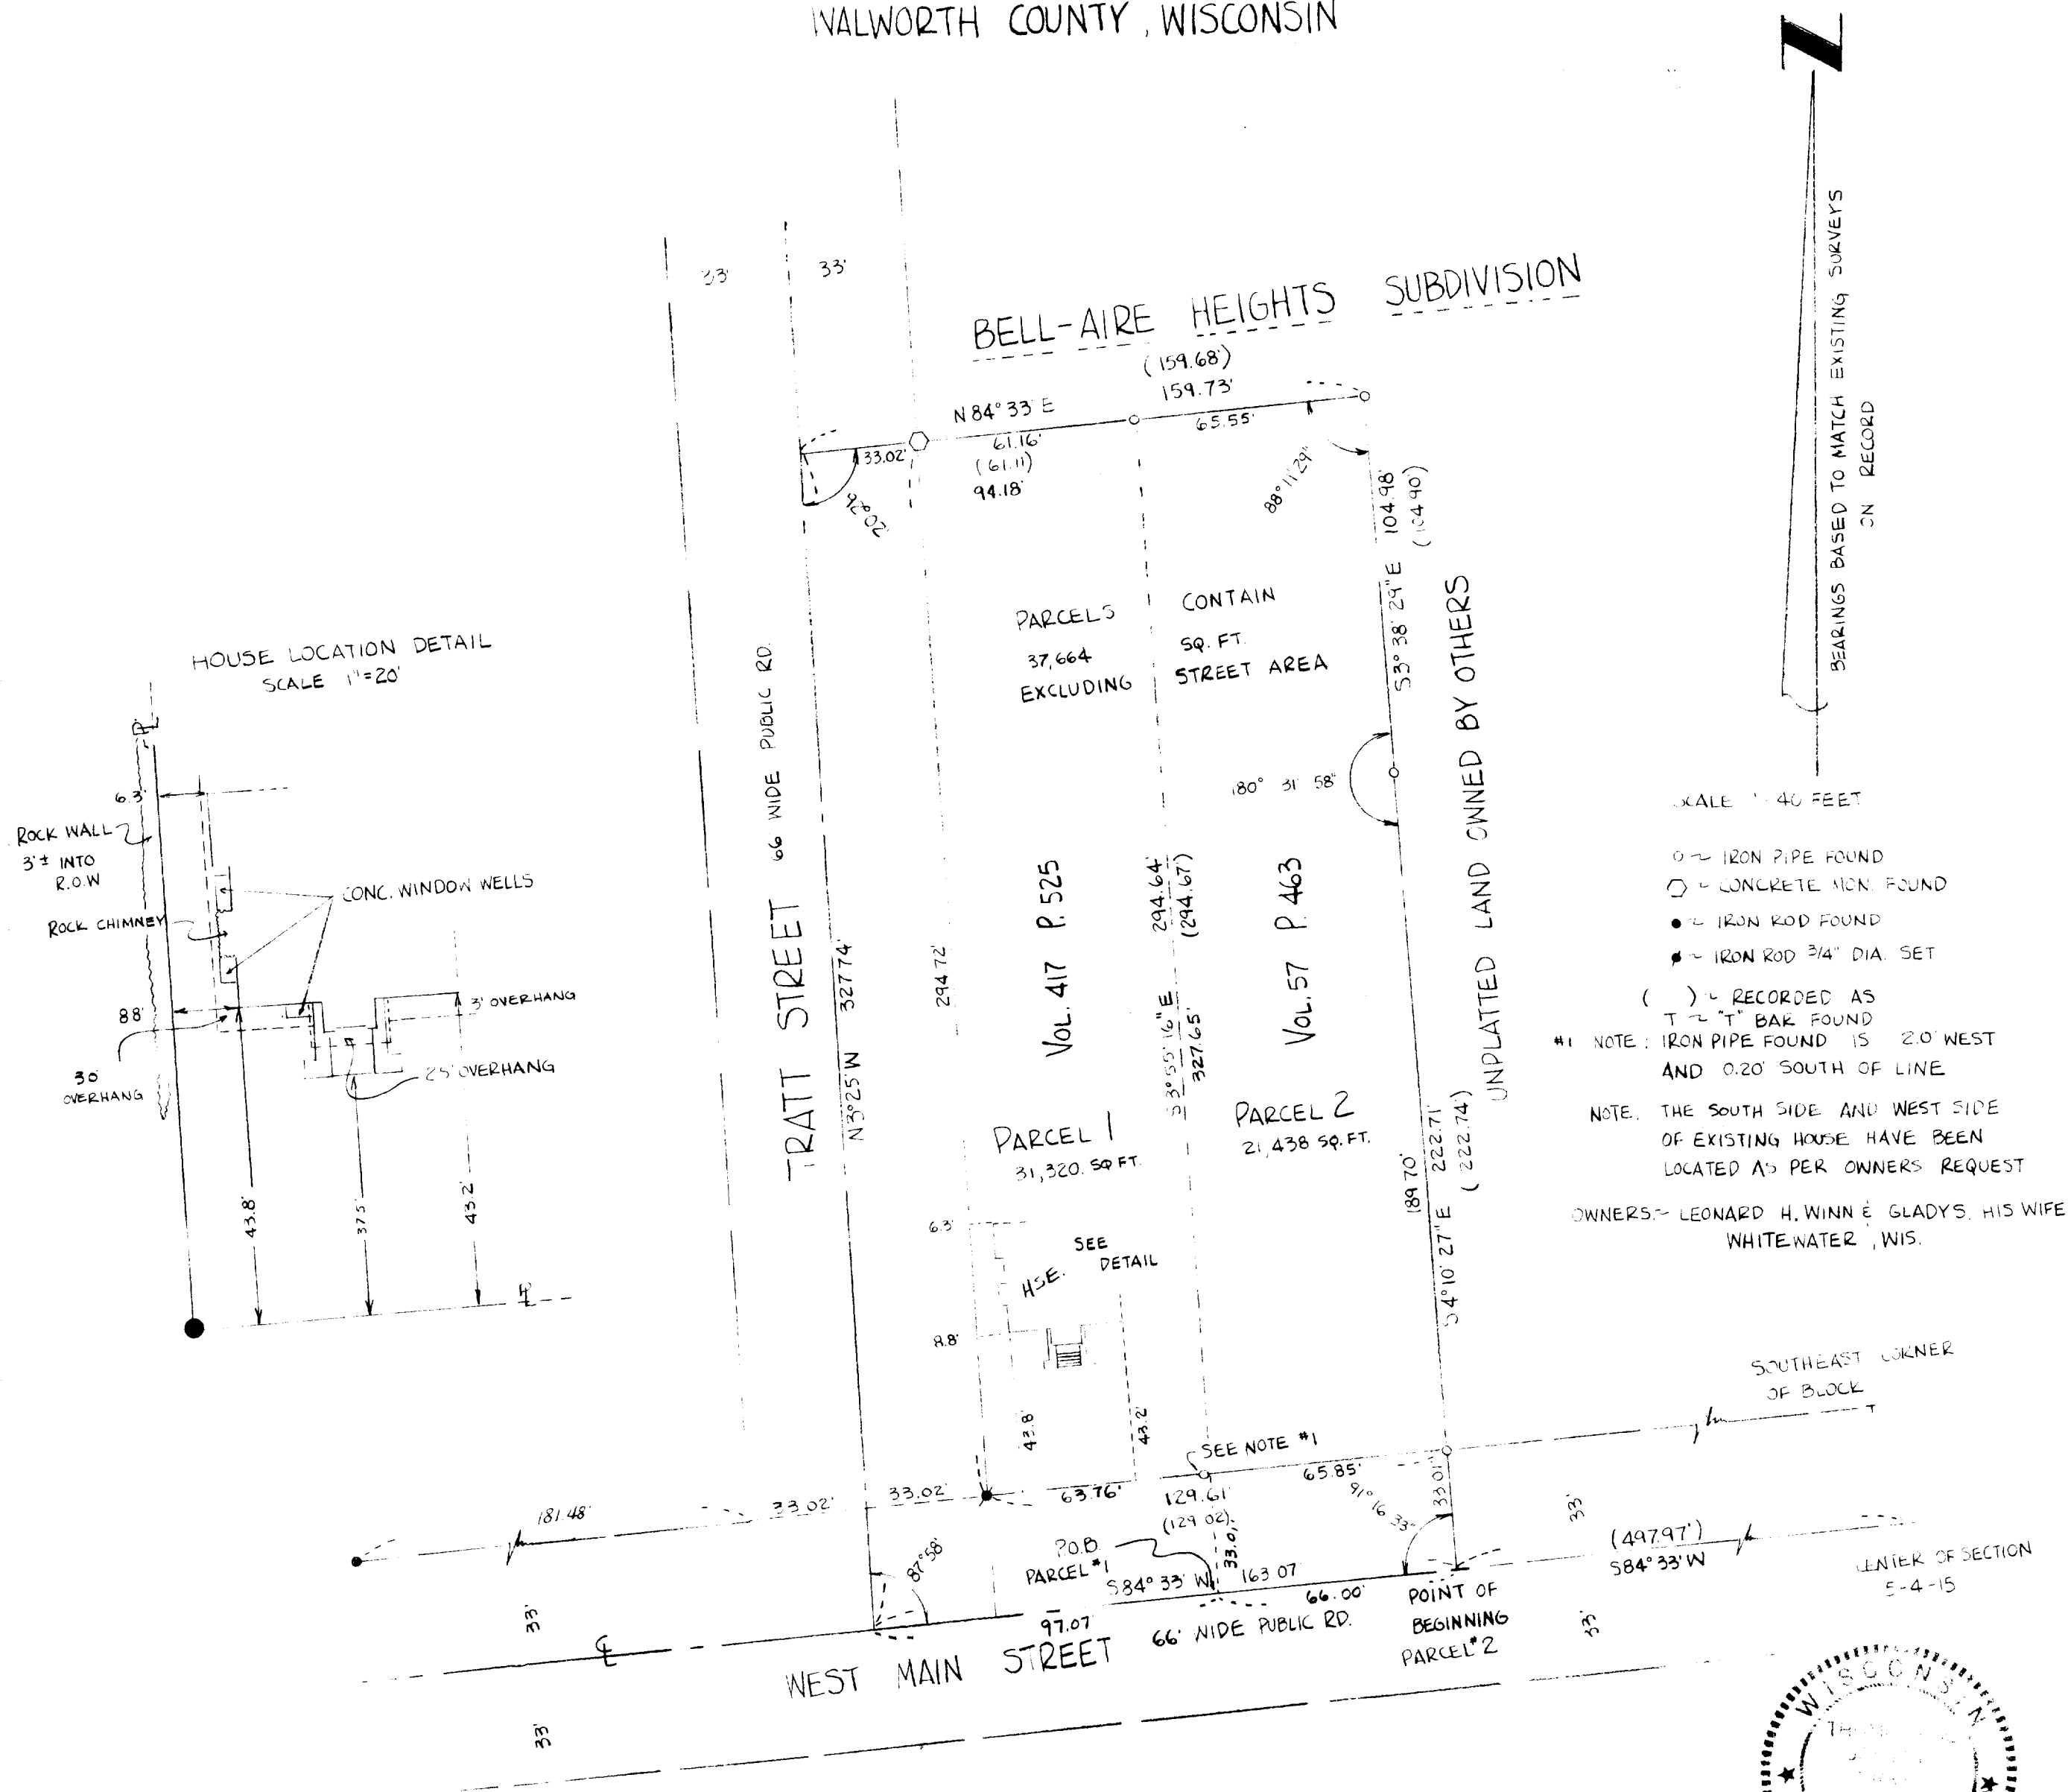

I HEREBY CERTIFY THAT I HAVE SURVEYED THE ABOVE DESCRIBED PARCEL OF LAND AND THAT THE PLAT HEREON DRAWN IS AN ACCURATE SURVEY AND A TRUE REPRESENTATION THEREOF AND CORRECTLY SHOWS THE BOUNDARY LINES OF SAID PROPERTY

FEB. 4, 1981

WISCONSIN
LAND SURVEYOR
THOMAS J. JENSEN
ELKHORN, WIS.
100
JENSEN SURVEYING & MAPPING
PO BOX 322
ELKHORN, WIS. 53121

WUP-167 + WUP-168

10-312-J ✓ # 981,002