


CA-2
Please split
Parcel

FARRIS, HANSEN & COOPER, INC.
ENGINEERING, SURVEYING AND LAND PLANNING
715 W. WALWORTH ST. P.O. BOX 467 - ELKHORN, WI 53121
OFFICE: 414/723-2000



MAP SCALE
1" = 30'

CLARK STREET
(50.16' WIDE)

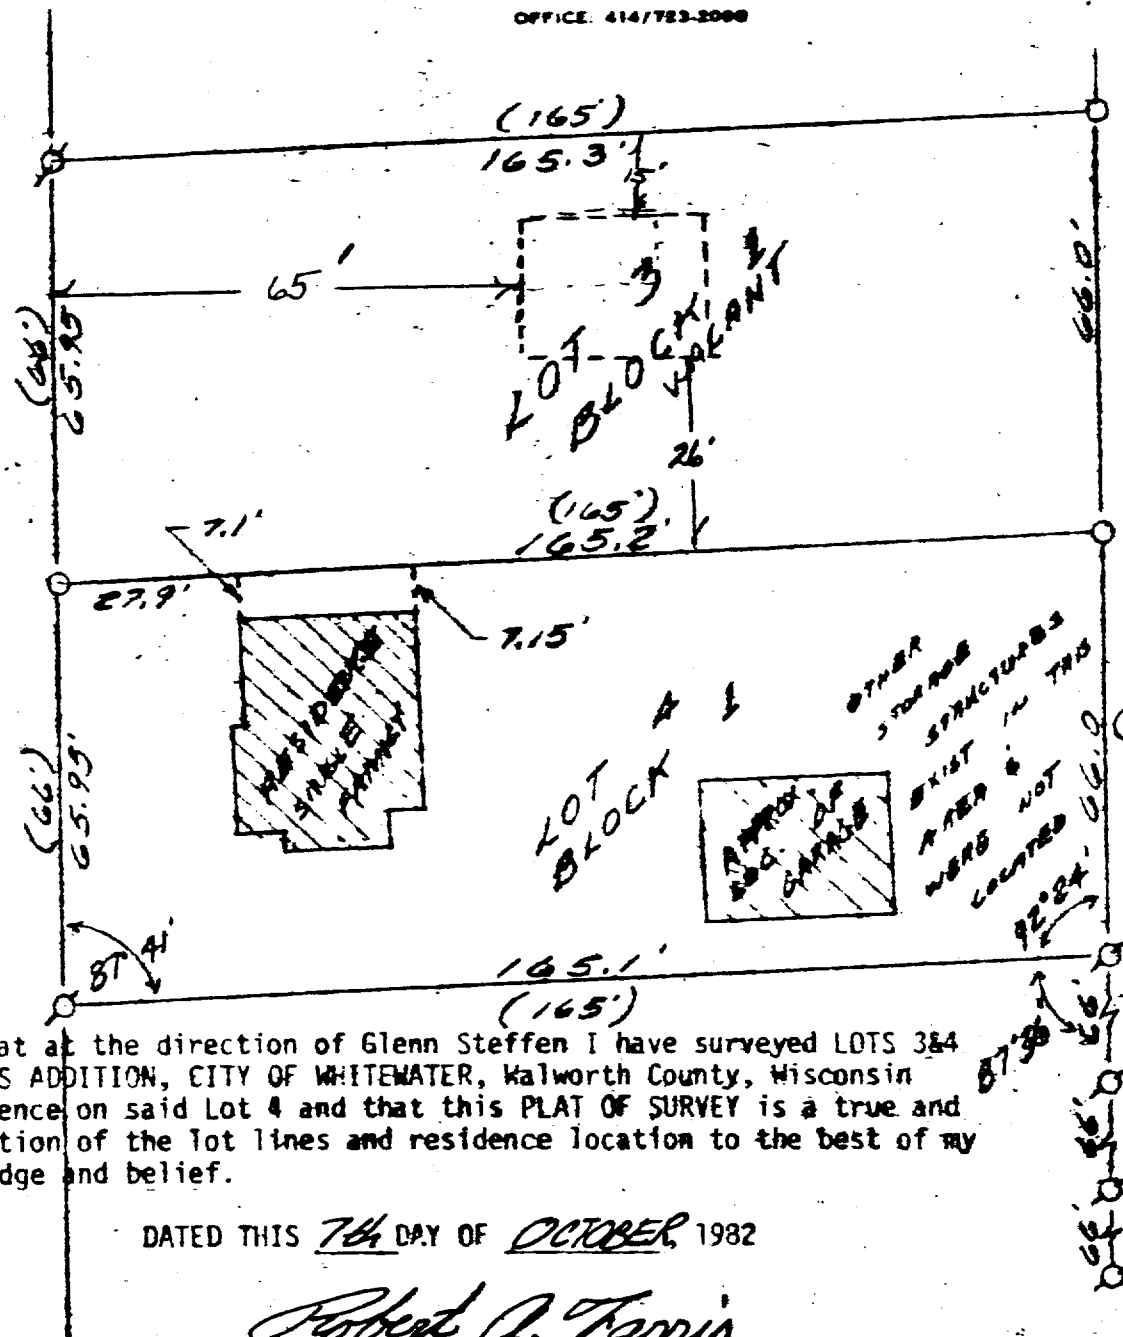


- X = IRON PIPE SURVEY STAKE FOUND
- O = 1" X 24" IRON PIPE STAKE SET
- (XXX) = RECORD DIMENSION

I HEREBY CERTIFY that at the direction of Glenn Steffen I have surveyed LOTS 3&4 of BLOCK 1 of CAINES ADDITION, CITY OF WHITEWATER, Walworth County, Wisconsin and located a residence on said Lot 4 and that this PLAT OF SURVEY is a true and accurate representation of the lot lines and residence location to the best of my professional knowledge and belief.

DATED THIS 7th DAY OF OCTOBER 1982

Robert A. Farris
Robert A. Farris, RLS

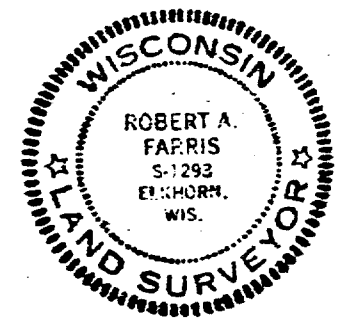

DRAWING NUMBER 2018

CA-2+2A

10-315-F