


**HAROLD R. KOLB**  
 REGISTERED PROFESSIONAL LAND SURVEYOR  
 LAKE GENEVA, WISCONSIN

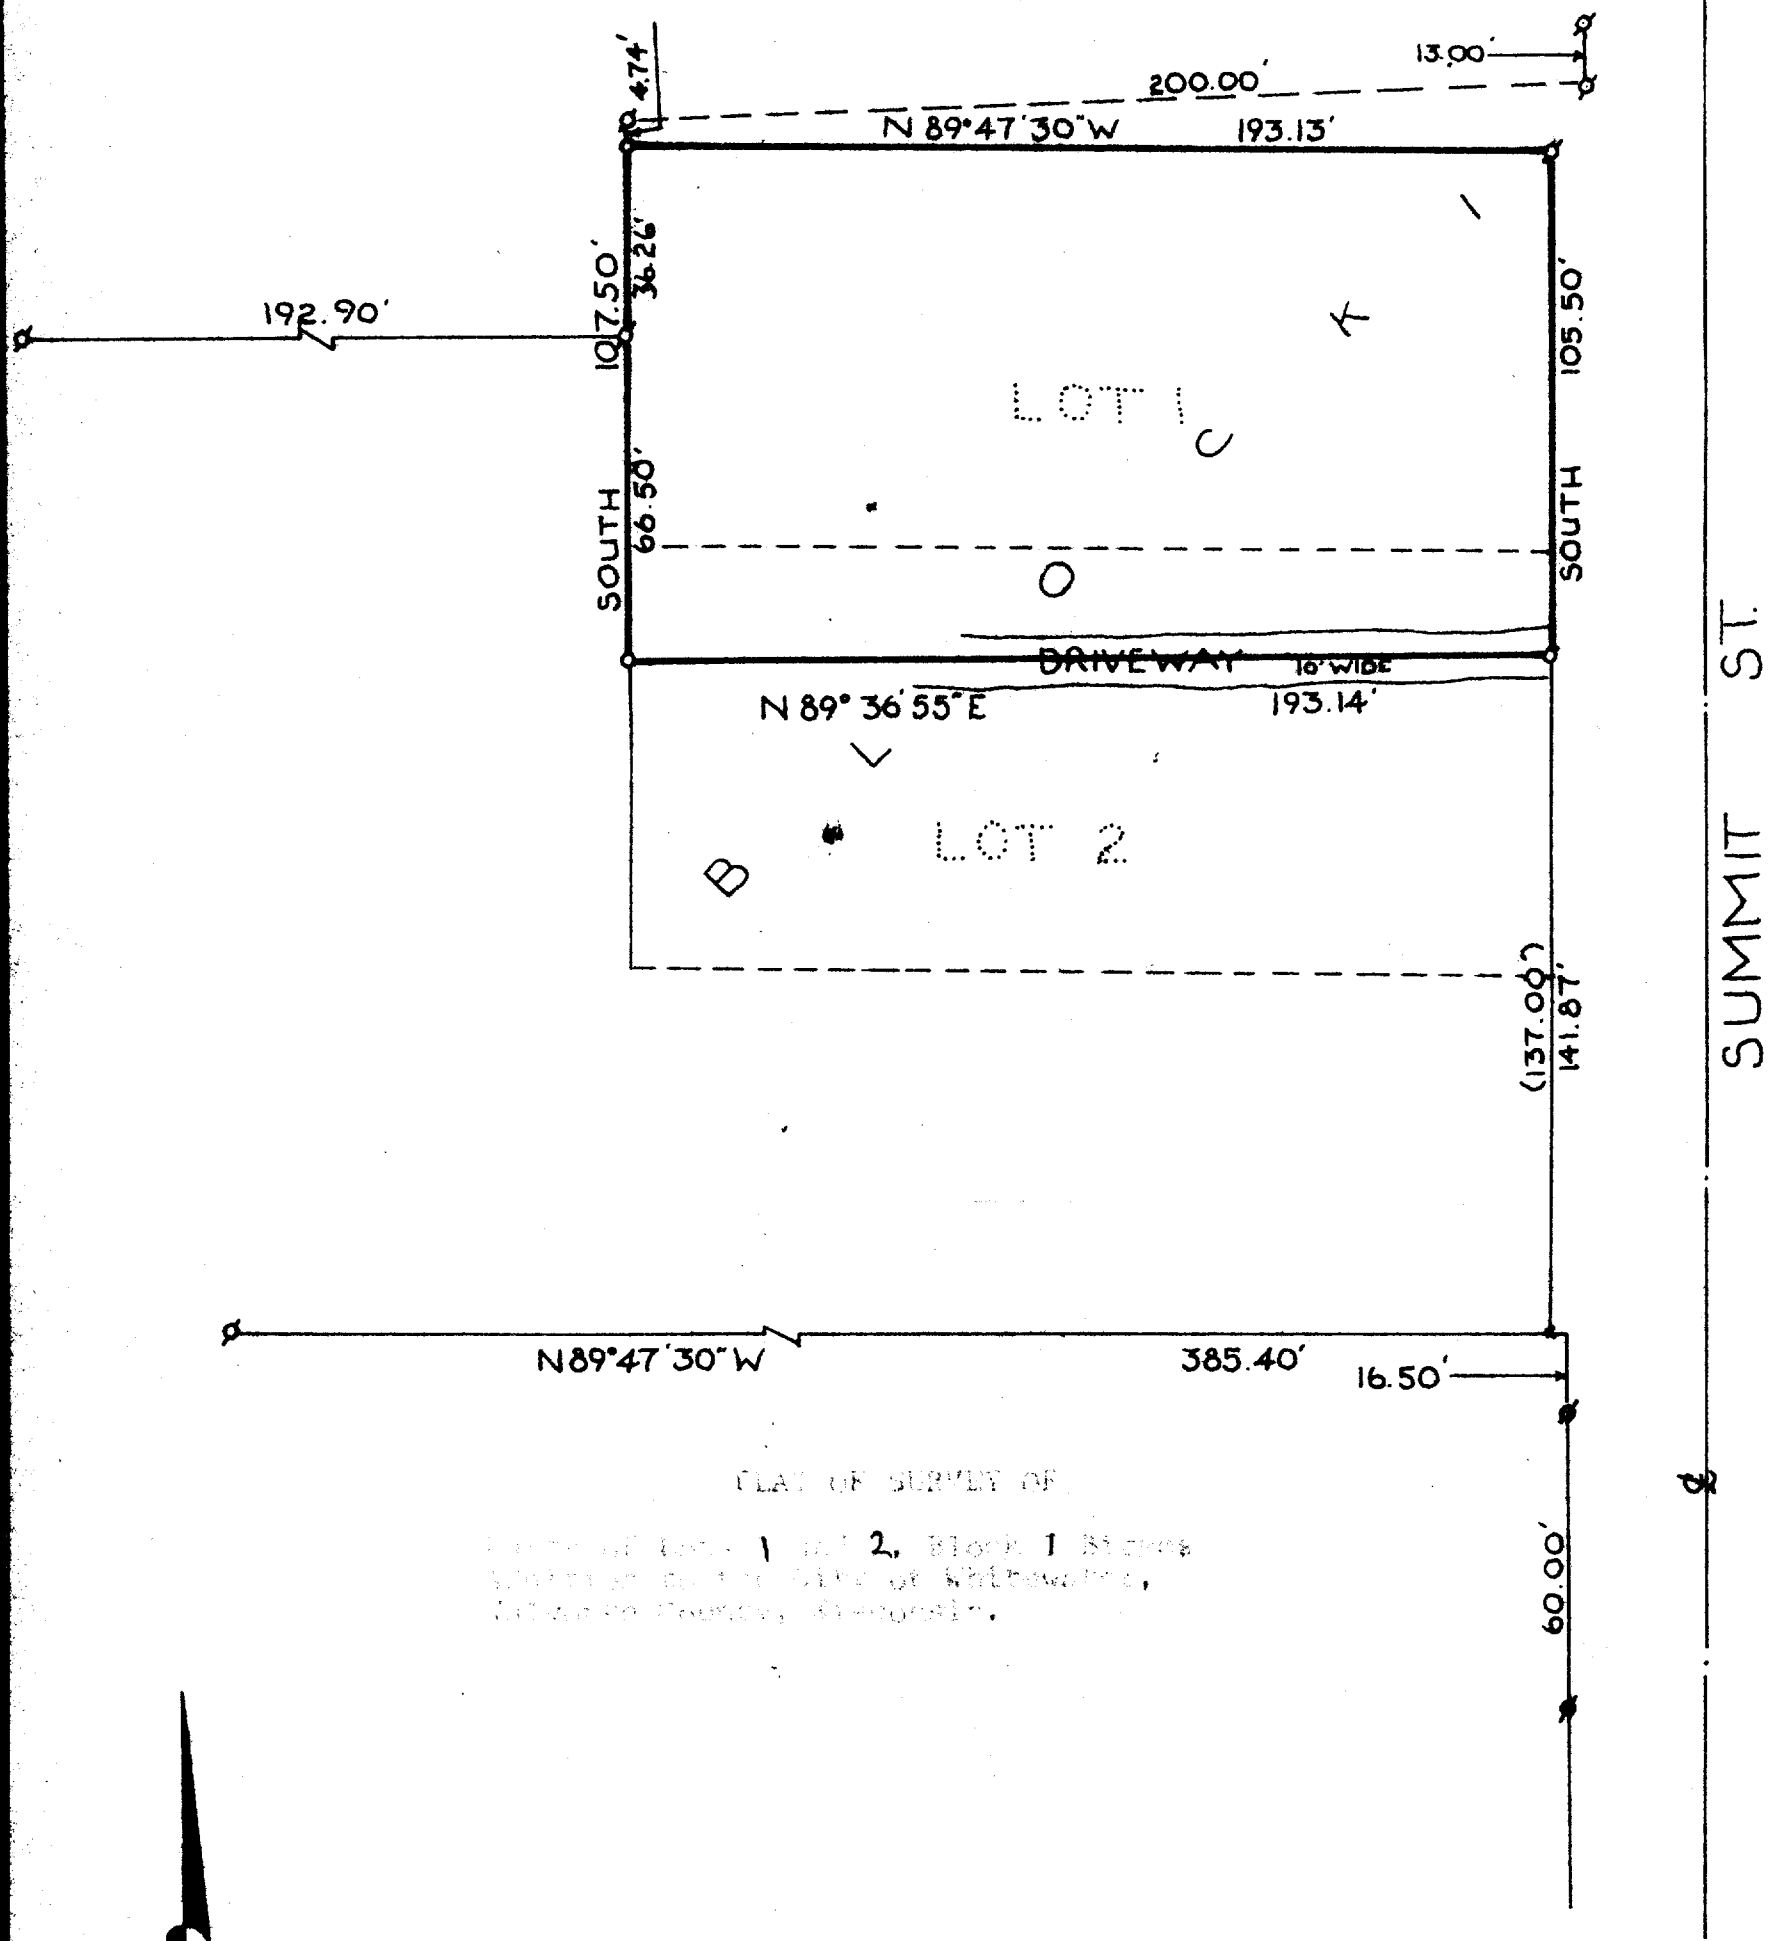

SCALE: 1" = 40'

**LEGEND**

- φ - IRON PIPE FOUND
- - IRON PIPE PLACED
- - CONCRETE MONUMENT
- x - SPIKE
- ⊗ - FOUND T-BAR
- ( ) - PLATTED AS

I, **JOSEPH BLONQUIST** DO HEREBY CERTIFY THAT I HAVE SURVEYED THE PROPERTY HEREON DESCRIBED ACCORDING TO THE OFFICIAL RECORDS, AND THAT THE PLAT HEREON IS A CORRECT REPRESENTATION OF THE LOT LINES.

*[Signature]*

**JOSEPH A. BLONQUIST**  
 WISCONSIN REGISTERED LAND SURVEYOR, S-1279

DATE 7-1-79