


DUNHAM SURVEYING, S.C.
SURVEYING & SUDPHODING
DELAVER, WISCONSIN 53115

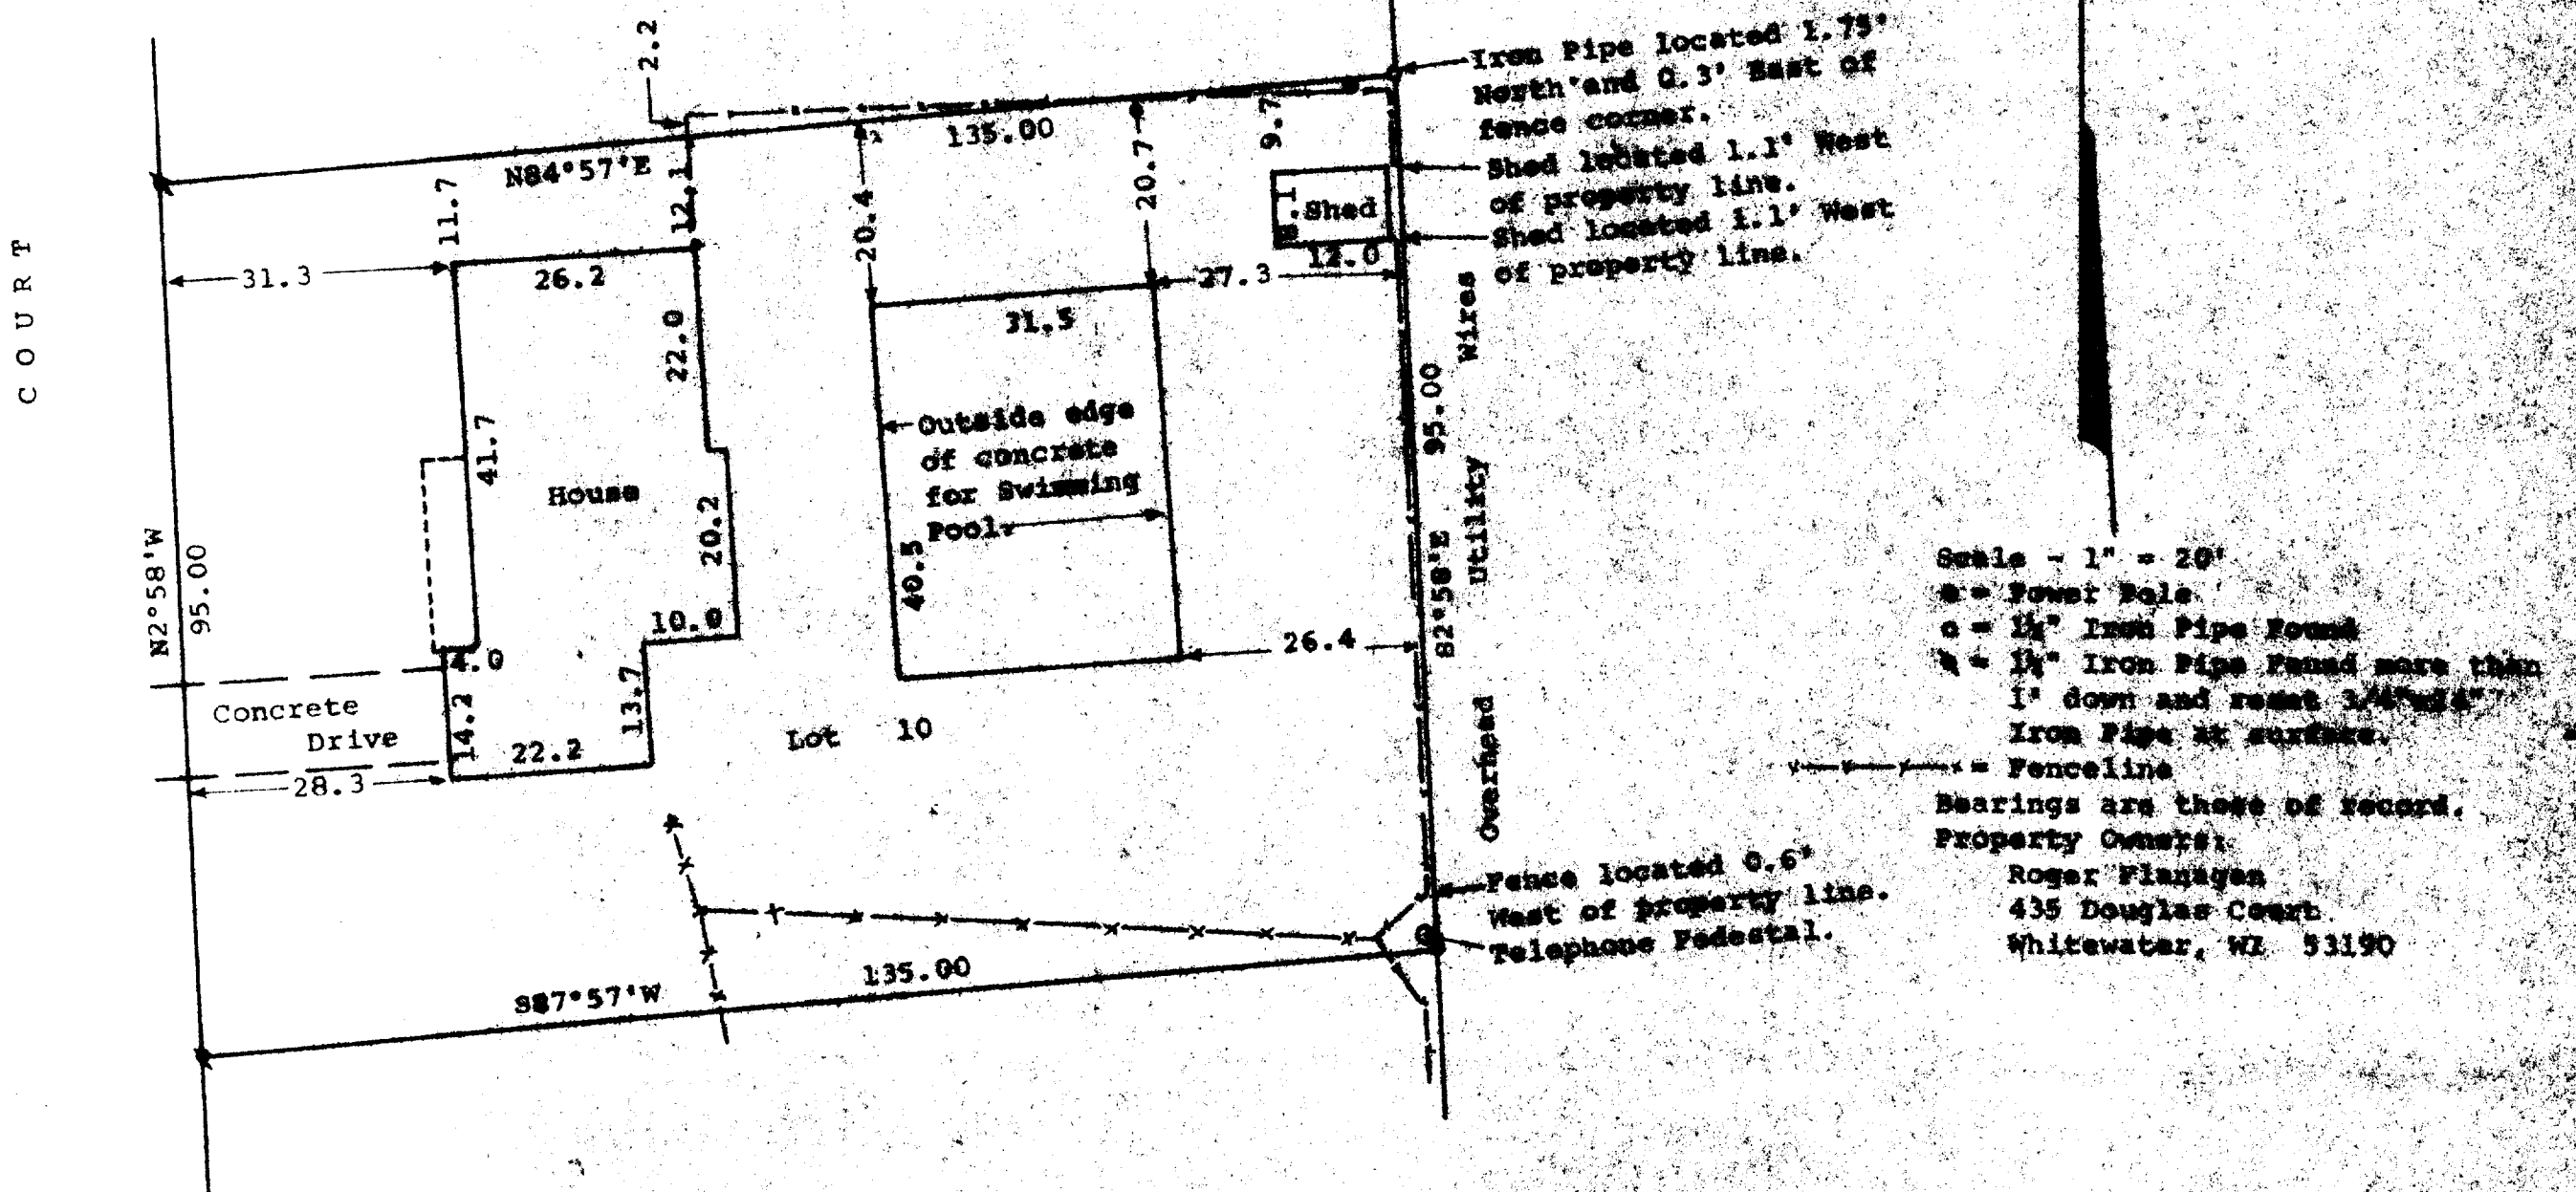

STATE OF WISCONSIN)
COUNTY OF WALMORTH) SS

I, George T. Dunham, Surveyor, certify that I have surveyed the property described as follows,

Lot 10 of Douglas Manor, a subdivision located in the Southeast ¼ of the Southwest ¼ of Section 5, T4N, R15E, City of Whitewater, Walworth County, Wisconsin.

and that the above map is a true representation thereof and shows the size and location of the property, its exterior boundaries, the location of all visible structures and dimensions of all principal buildings thereon, boundary fences, apparent easements, roadways and visible encroachments, if any, and that I have surveyed the property hereon described according to the official records, to the best of my knowledge and belief.

July 13, 1983.

George F. Dunham
George F. Dunham, Surveyor

