




D.D. COOPER & CO. INC.

ROUTE 4 BOX 101 B
ELKHART, IN 46517


PH 414-723-6265

SURVEYING • MODULAR HOMES

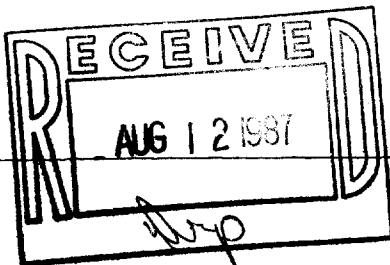

HIGHLAND STREET

BEARING REFERENCE
EASTERLY LINE OF PARCEL
ASSUMED TO BEAR N3°24'W
AS PLATTED ON OTHER SURVEYS
IN THIS BLOCK

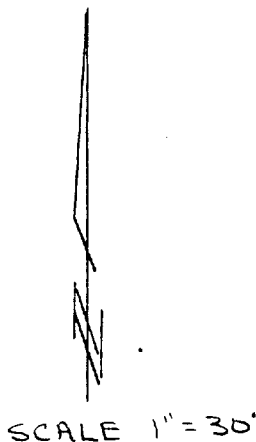


DESCRIPTION OF RECORD
PART OF BLOCK 5 BIRGES ADDITION TO THE
CITY OF WHITEWATER WALWORTH COUNTY WISCONSIN
DESCRIBED AS BEGINNING AT A POINT 191.5 FEET
EAST OF THE NORTHWEST CORNER OF BLOCK 5
THENCE SOUTH 181.5 FEET THENCE WEST 74.5 FEET
THENCE NORTH 181.5 FEET THENCE EAST 74.5
FEET TO THE POINT OF BEGINNING

NOTE
THE PROPERTY AS FOUND TO BE MONUMENTED AND OCCUPIED IS 9.58 FEET SHORTER IN LENGTH
THEN THE DESCRIPTION OF RECORD



I, DANIEL D. COOPER, REGISTERED SURVEYOR, DO HEREBY CERTIFY THAT
I HAVE SURVEYED THE PROPERTY DESCRIBED HEREON AND THAT THE MAP
SHOWN HEREON IS A TRUE AND ACCURATE REPRESENTATION THEROF TO THE
BEST OF MY PROFESSIONAL KNOWLEDGE AND BELIEF.

DATED THIS 10 DAY OF DEC. 1985 *Daniel D. Cooper*
DANIEL D. COOPER, RLS NO. S-1464

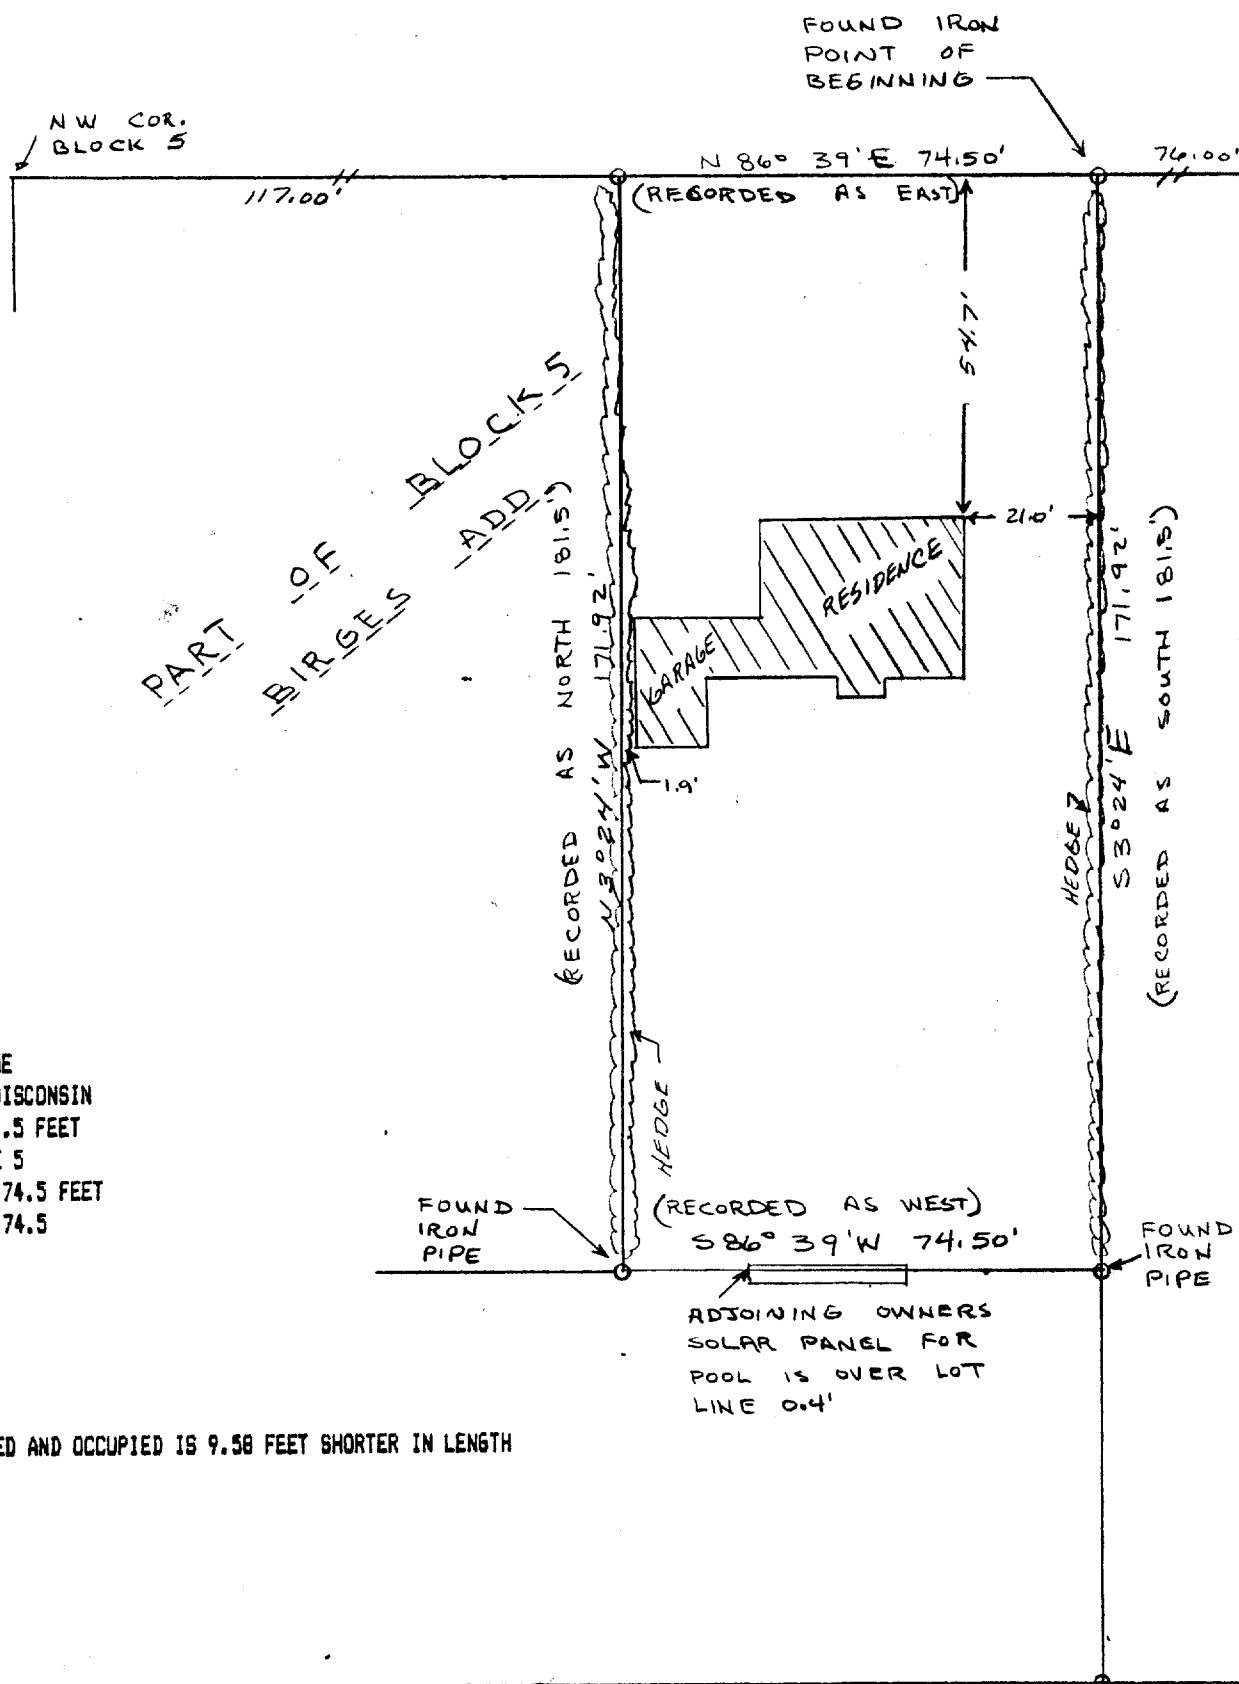

DRAWING NO. 2094

10-376 -3-28